


STATE OF KANSAS
STATE CORPORATION COMMISSION

WELL PLUGGING RECORD

Get All Information Completely
Take Required Affidavit
Mail or Deliver Report to
Conservation Division
State Corporation Comm.
245 North Water
Wichita, KS 67202

Ness County. Sec. 20 Twp. 20 Rge. 23 E/W
Location as "NE/CNW $\frac{1}{2}$ SW $\frac{1}{2}$ " or footage from lines
NE SW NW

Lease Owner Hoppe Oil & Gas Co.
Lease Name Burditt "A" Well No. 1
Office Address Box 18678, Wichita, Kansas 67218
Character of Well (Completed as Oil, Gas or Dry Hole)
Dry Hole

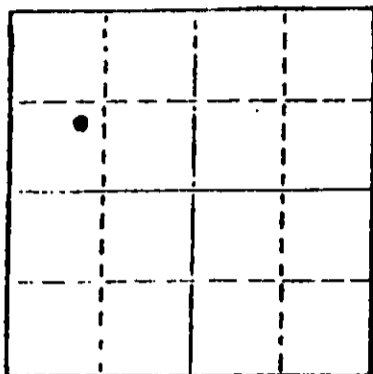

Locate well correctly on above
Section Plot

Date Well completed 5-221981
Application for plugging filed 5-221981
Application for plugging approved 5-221981
Plugging commenced 5-221981
Plugging completed 5-221981
Reason for abandonment of well or producing formation
No commercial quantity of oil or gas encountered.
If a producing well is abandoned, date of last production 19

Was permission obtained from the Conservation Division or
its agents before plugging was commenced? yes

Name of Conservation Agent who supervised plugging of this well Marion Schmidt
Producing formation _____ Depth to top _____ Bottom _____ Total Depth of Well _____
Show depth and thickness of all water, oil and gas formations.

OIL, GAS OR WATER RECORDS

CASING RECORD

FORMATION	CONTENT	FROM	TO	SIZE	PUT IN	PULLED OUT

Describe in detail the manner in which the well was plugged, indicating where the mud fluid
was placed and the method or methods used in introducing it into the hold. If cement or other
plugs were used, state the character of same and depth placed, from _____ feet to
_____ feet for each plug set.

T.D. 4520'. Set 1st plug @ 840' with 65 sacks cement, 2nd plug @ 270' with
30 sacks cement, bridge @ 40' with 10 sacks and 5 sacks in rathole. Cement
by Allied Cementing. Plug down @ 5:15 P.M. on 5/22/81. State plugger -
Marion Schmidt.

(If additional description is necessary, use BACK of this sheet)

Name of Plugging Contractor KAW Drilling Co., Inc.

STATE OF KANSAS COUNTY OF SEDGWICK, ss.
K.S. Martin, President of KAW Drilling Co., Inc. (and owner of same) do hereby certify that
of the above described well, being first duly sworn on oath, says: That I have knowledge of
the facts, statements, and matters herein contained and the log of the above-described well
as filed and that the same are true and correct. So help me God.

(Signature) K.S. Martin
K.S. Martin, President - 1010 Union Center
(Address) Wichita, KS 67202

SUBSCRIBED AND SWORN TO before me this 26th day of May, 1981.

My commission expires December 10, 1983

Mary Susan Whaley
NOTARY PUBLIC
STATE OF KANSAS
My Appt. Exp. 12-10-83
RECEIVED
STATE CORPORATION COMMISSION
MAY 28 1981
KANSAS

OPERATOR:
 CONTRACTOR:
 WELL NAME:
 LOCATION:
 SPUD DATE:
 COMPLETION DATE:

HOPPE OIL & GAS CO.
 KAW Drilling Co., Inc.
 BURDITT "A" #1
 NE SW NW Section 20-20S-23W
 Ness County, Kansas
 May 14, 1981
 May 22, 1981

0	3899	Shale
3900	4520	Shale & Lime
	4520	R.T.D.

Spud hole @ 10:30 A.M. on 5/14/81. Drilled 689' of 12 1/4" hole. Ran 15 joints of 8 5/8" 24# new surface casing. (Tallied 677.89') Set at 689' with 325 sacks common cement, 2% Gel, 3% CC. Plug down @ 10:30 P.M. on 5/14/81.

T.D. 4520'. Set 1st plug @ 840' with 65 sacks cement, 2nd plug @ 270' with 30 sacks cement, bridge @ 40' with 10 sacks and 5 sacks in rathole. Cement by Allied Cementing. Plug down @ 5:15 P.M. on 5/22/81. State Plugger - Marion Schmidt.

STATE OF KANSAS)
) ss
 COUNTY OF SEDGWICK)


I, K. S. Martin, President of KAW Drilling Co., Inc., being first duly sworn and upon my oath, state that: I have knowledge of the facts, statements and matters herein contained and the log of the above described well as filed and that the same are true and correct. So help me God.

K. S. Martin
 K. S. Martin, President

SUBSCRIBED AND SWORN to before me on this 26th day of May, 1981.

Mary Susan Whaley
 Mary Susan Whaley, Notary Public

My Commission Expires:
 December 10, 1983

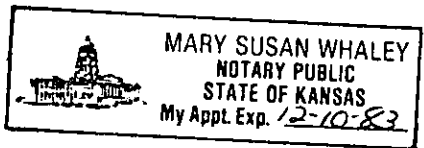

RECEIVED
 STATE CORPORATION COMMISSION
 MAY 26 1981
 CONSERVATION DIVISION
 Wichita, Kansas