

15.135.21304-0000

Give All Information Completely
Make Required Affidavit
Mail or Deliver Report to:
Conservation Division
State Corporation Commission
211 No. Broadway
Wichita, Kansas

WELL PLUGGING RECORD

Ness County, Sec. 1 Twp. 20S Rge. 24W (E) (W)

Location as "NE/CNW/SW" or footage from lines NW SE SW

Lease Owner Kaiser-Francis Oil Company

Lease Name Petersilie "I" Well No. 1

Office Address 4120 E. 51st St. -Tulsa, Oklahoma 74135

Character of Well (completed as Oil, Gas or Dry Hole) Dry Hole

Date well completed 4/7/77 19

Application for plugging filed 4/7/77 19

Application for plugging approved 4/7/77 19


Plugging commenced 4/7/77 19

Plugging completed 4/7/77 19

Reason for abandonment of well or producing formation Dry Hole

If a producing well is abandoned, date of last production 19

Was permission obtained from the Conservation Division or its agents before plugging was commenced? Yes

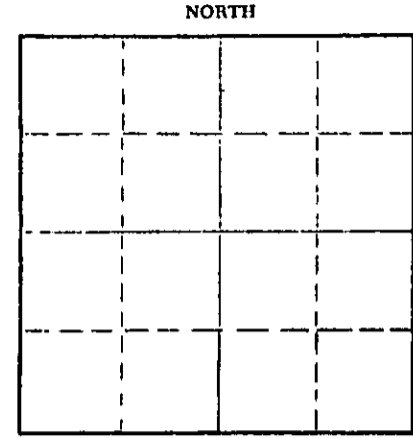

Locate well correctly on above Section Plat

Name of Conservation Agent who supervised plugging of this well Leo Massey

Producing formation Depth to top Bottom Total Depth of Well Feet

Show depth and thickness of all water, oil and gas formations.

OIL, GAS OR WATER RECORDS

CASING RECORD

FORMATION	CONTENT	FROM	TO	SIZE	PUL IN	PULLED OUT
	Surface	0	641	8-5/8"	641	0

Describe in detail the manner in which the well was plugged, indicating where the mud fluid was placed and the method or methods used in introducing it into the hole. If cement or other plugs were used, state the character of same and depth placed, from feet to feet for each plug set.

1st Plug @ 660' w/50 sx
2nd Plug @ 240' w/25 sx
3rd Plug @ 40' w/10 sx

4-13-77

Name of Plugging Contractor Thunderbird Drilling, Inc.
Address P. O. Box 18704- Wichita, Kansas 67218

STATE OF KANSAS, COUNTY OF SEDGWICK, ss. Burke Krueger

(employee of owner) or (owner or operator) of the above-described well, being first duly sworn on oath, says: That I have knowledge of the facts, statements, and matters herein contained and the log of the above-described well as filed and that the same are true and correct. So help me God.

(Signature) [Signature]

P. O. Box 18407- Wichita, Kansas 67218

SUBSCRIBED AND SWORN to before me this 12th day of April, 1977

My commission expires 3-25-80 Gloria DeJesus Notary Public.



K. 135. 21304-0000

RILLERS LCG

Company Kaiser-Francis Oil Company

Contractor Thunderbird Drilling, Inc.

Elevation 2315' K.B.

Farm Petersilie "I"

Well No. 1 Casing 8-5/8" @ 641' w/300 sx

Location NW SE SW
Sec. 1-20S-24W

Production

County Ness County, Kansas

<u>From</u>	<u>To</u>	<u>Description</u>
0	641	Surface Hole
641	775	Shale & Sand Strks.
775	955	Shale
955	965	Blaine Anhydrite
965	1040	Shale
1040	1260	Sand
1260	1270	Shale
1270	1606	Sand & Shale
1576	1616	Anhydrite
1606	2210	Shale & Shells
2210	2366	Shale & Lime Strks.
2366	3935	Shale & Lime
3935	4045	Lime & Shale
4045	4185	Shale & Lime
4185	4235	Lime & Shale
4235	4343	Lime
4343	4350	Lime & Shale
4350	4442	Lime
4442	T.D.	

RECORDED
APR 13 1977

STATE OF KANSAS)
) ss.
COUNTY OF SEDGWICK)

I, Burke Krueger, of Thunderbird Drilling, Inc. upon oath states that the above and foregoing is a true and correct copy from the Daily Drilling Report from your Petersilie "I"-1.

Burke Krueger

Subscribed and sworn to before me this 12th day of April, 19 77.



Gloria DeJesus
Gloria DeJesus Notary Public

My commission expires: 3-25-80