


STATE OF KANSAS
STATE CORPORATION COMMISSION
Give All Information Completely
Make Required Affidavit
Mail or Deliver Report to:
Conservation Division
State Corporation Commission
800 Biting Building
Wichita, Kansas

WELL PLUGGING RECORD

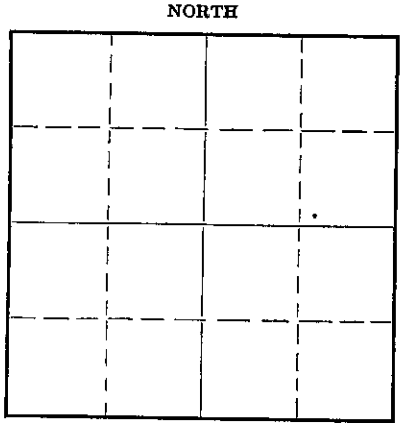

Locate well correctly on above Section Plat

Rush County. Sec. 14 Twp. 16 Rge. (E) 16 (W)
Location as "NE/CNW $\frac{1}{4}$ SW $\frac{1}{4}$ " or footage from lines SE SE NE $\frac{1}{4}$
Lease Owner M. B. Armer
Lease Name Taylor Well No. 1
Office Address 710 Petroleum Bldg. Wichita, Kansas
Character of Well (completed as Oil, Gas or Dry Hole) Dry
Date well completed August 8 19 51
Application for plugging filed August 8 19 51
Application for plugging approved August 8 19 51
Plugging commenced August 8 19 51
Plugging completed August 8 19 51
Reason for abandonment of well or producing formation Dry

If a producing well is abandoned, date of last production 19
Was permission obtained from the Conservation Division or its agents before plugging was commenced? Yes

Name of Conservation Agent who supervised plugging of this well C. D. Stough
Producing formation _____ Depth to top _____ Bottom _____ Total Depth of Well 3,570 Feet
Show depth and thickness of all water, oil and gas formations.

OIL, GAS OR WATER RECORDS

CASING RECORD

Formation	Content	From	To	Size	Put In	Pulled Out
				13-3/8	70	None

Describe in detail the manner in which the well was plugged, indicating where the mud fluid was placed and the method or methods used in introducing it into the hole. If cement or other plugs were used, state the character of same and depth placed, from _____ feet to _____ feet for each plug set.

Filed hole with heavy mud to 300 ft.
Bridged hole at 300 ft., cemented by pump truck with 125 sacks cement from 300 ft. to top of surface casing.

RECEIVED
STATE CORPORATION COMMISSION

AUG 10 1951

(If additional description is necessary, use BACK of this sheet)

Correspondence regarding this well should be addressed to M. B. Armer
Address _____

STATE OF Kansas, COUNTY OF Sedgewick, ss.
L. C. Sponenberg (Employee of owner) of the above-described well,
being first duly sworn on oath, says: That I have knowledge of the facts, statements, and matters herein contained and the log of the above-described well as filed and that the same are true and correct. So help me God.

(Signature) L. C. Sponenberg
710 Petroleum Bldg. Wichita, Kansas
(Address)

SUBSCRIBED AND SWORN TO before me this 9th day of August, 1951

Hazel Walton
Notary Public.

My commission expires _____

28-3273-s 4-50-10M
PLUGGING
FILED AUG 14 1951
BOOK PAGE 10 LINE 11

LOG

Company: M. B. Armer, Bay Petroleum Corporation & Beardmore Drilling Company
 Contractor: M. B. Armer
 Drilling commenced: 7/26/51
 Drilling completed: 8/8/51
 Elevation: 1950 D. F. 1953 R. B.

Farm: Taylor - well #1
 Location: SE SE SE Sec. 14-16S-16W, Rush County, Kansas
 Casing record: 13-3/8" set @ 70' cemented w/75 sacks

(figures below indicate bottom)

Shale & shells	69
Shale, sand & shells	315
Shale & shells	435
Sand	600
Shale & red bed	1050
Shale & shells	1060
Anhydrite	1095
Shale & shells	1350
Red bed, shale & shells	1700
Red bed & shells	1800
Shale & lime	1850
Shale, shells & lime	2090
Lime	2205
Lime & shale	2520
Shale & shells	2800
Shale & lime Strks.	2955
Lime & shale	3275
Lime	3375
Lime & iron	3380
Lime	3504
Conglomerate	3543
Dolomite	3570
Rotary Total Depth	3570 D & A

FORMATION TOPS: (R. B. Meas.)

Heebner	3190
Toronto	3206
Kansas City	3248
Conglomerate	3504
Arbuckle	3543

I hereby certify that this is a true and correct log of the above described well as shown by the drilling reports.

M. B. ARMER

STATE OF KANSAS)
) SS
 COUNTY OF SEDGWICK)

By *Hazel Waite*
 AUG 10 1951

Subscribed and sworn to before me, a notary public, in and for said County and State this 9th day of August, 1951.

Hazel Waite
 Notary Public.

My commission expires Sept. 17, 1951.

PLUGGING
 FILE SEC 14-16S-16W
 BOOK PAGE 101 LINE 41