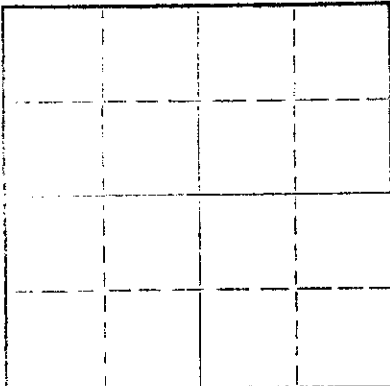


STATE OF KANSAS
STATE CORPORATION COMMISSION

Form CP-4

Give All Information Completely
Make Required Affidavit
Mail or Deliver Report to:
Conservation Division
State Corporation CommissionP. O. Box 17027
Wichita, Kansas 67217
NORTH

WELL PLUGGING RECORD

Locate well correctly on above
Section Plat

Rush County Sec. 11 Twp. 16S Rge. 16W (E) (W)
Location as "NE, CNW, SW" or footage from lines SW NE NE
Lease Owner Clinton Oil Company
Lease Name Suppes Well No. 1-V
Office Address 217 North Water, Wichita, Kansas 67202
Character of Well (completed as Oil, Gas or Dry Hole) D & A
Date well completed March 26 19 74
Application for plugging filed March 26 19 74
Application for plugging approved March 26 19 74
Plugging commenced March 26 19 74
Plugging completed March 26 19 74
Reason for abandonment of well or producing formation D & A

If a producing well is abandoned, date of last production 19
Was permission obtained from the Conservation Division or its agents before plugging was commenced? Yes

Name of Conservation Agent who supervised plugging of this well Mr. Leo F. Massey
Producing formation Depth to top Bottom Total Depth of Well 3524 Feet
Show depth and thickness of all water, oil and gas formations.

OIL, GAS OR WATER RECORDS

CASING RECORD

FORMATION	CONTENT	FROM	TO	SIZE	PUT IN	PULLED OUT
				10-3/4"	201'	-0-

Describe in detail the manner in which the well was plugged, indicating where the mud fluid was placed and the method or methods used in introducing it into the hole. If cement or other plugs were used, state the character of same and depth placed, from feet to feet for each plug set.

Filled Hole W/Mud, Cemented W/70 Sx. @ 500',
Cemented W/30 Sx. @ 185', Cemented W/15 Sx.
@ 40'.

RECEIVED
STATE CORPORATION COMMISSION
APR 1 - 1974
CONSERVATION DIVISION
Wichita, Kansas

(If additional description is necessary, use BACK of this sheet)
Name of Plugging Contractor Red Tiger Drilling Company
Address 1720 Wichita Plaza, Wichita, Kansas 67202


STATE OF Kansas COUNTY OF Sedgwick, ss.
Linda H. Dickens (employee of owner) or (owner or operator) of the above-described well, being first duly sworn on oath, says: That I have knowledge of the facts, statements, and matters herein contained and the log of the above-described well as filed and that the same are true and correct. So help me God.

(Signature) Linda H. Dickens
1720 Wichita Plaza, Wichita, Kansas 67202
(Address)

Subscribed and sworn to before me this 27th day of March, 19 74

October 25, 1976

Notary Public.

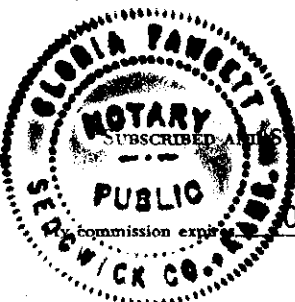

DRILLERS LOG

No. 1-V Suppes

CASING RECORD:

10-3/4" @ 201'
w/225 sx cement

COMPANY:

Clinton Oil Co.

DESCRIPTION:

SW NE NE
11-16S-16W
Rush County,
Kansas

TOTAL DEPTH: 3524'

COMPLETED:

March 26, 1974

ELEVATION:

<u>FORMATION</u>	<u>FROM</u>	<u>TO</u>	<u>REMARKS</u>
Post Rock	0	40	
Shale	40	455	
Sand	455	640	
Redbed	640	997	
Anhydrite	997	1040	
Shale & Redbed	1040	1290	
Shale & Shells	1290	1760	
Shale & Lime	1760	1995	
Lime & Shale	1995	2120	
Shale & Lime	2120	2325	
Shale w/Lime	2325	2465	
Shale & Lime	2465	2730	
Shale w/Lime	2730	2860	
Shale & Lime	2860	3035	
Lime w/Shale	3035	3135	
Lime	3135	3330	
Lime w/Shale	3330	3375	
Lime	3375	3485	
Cherty Conglomerate	3485	3524	

RECEIVED
STATE CORPORATION COMMISSION
APR 1 - 1974
CONSERVATION DIVISION
Wichita, Kansas

I certify that this is a true and correct copy of the above log to the best of my knowledge.

RED TIGER DRILLING COMPANY

Linda H. Dickens
Linda H. Dickens

Subscribed and sworn to before me this 27th day of March, 1974.



Gloria Lawcett
Notary Public

My Commission Expires:

October 25, 1976