


15-165-38374-0000

STATE OF KANSAS
STATE CORPORATION COMMISSION

Give All Information Completely
Make Required Affidavit
Mail or Deliver Report to:
Conservation Division
State Corporation Commission
800 Bittling Building
Wichita, Kansas

WELL PLUGGING RECORD

NORTH

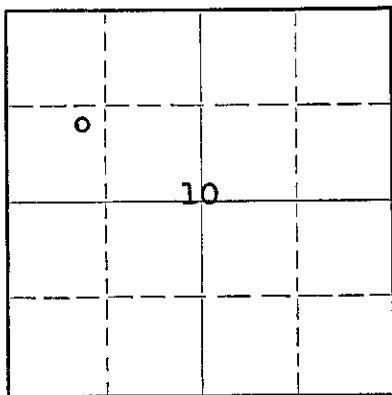

Locate well correctly on above
Section Plat

Rush County. Sec. 10 Twp. 16S Rge. 16 (NE SW NW)
Location as "NE/CNW $\frac{1}{4}$ SW $\frac{1}{4}$ " or footage from lines NE SW NW
Lease Owner Northern Pump Company
Lease Name Hopkins Well No. 1
Office Address Box 317, Great Bend, Kansas
Character of Well (completed as Oil, Gas or Dry Hole) Dry Hole
Date well completed April 19 1952
Application for plugging filed April 19 1952
Application for plugging approved April 21 1952
Plugging commenced April 21 1952
Plugging completed April 21 1952
Reason for abandonment of well or producing formation Dry Hole

If a producing well is abandoned, date of last production 19
Was permission obtained from the Conservation Division or its agents before plugging was commenced? Yes

Name of Conservation Agent who supervised plugging of this well C. D. Stough
Producing formation Depth to top Bottom Total Depth of Well 3586' Feet
Show depth and thickness of all water, oil and gas formations.

OIL, GAS OR WATER RECORDS

CASING RECORD

Formation	Content	From	To	Size	Put In	Pulled Out
	Sample	Schlumberger		8-5/8"	905'	None
Topeka	2990' -1027'	2946'				
Heebner	3192' -1229'	3166'				
Ks. City	3244' -1281'	3222'				
Base Ks. City	3450' -1487'	3452'				
Conglomerate	3470' -1507'	3482'				
Arbuckle	3526' -1563'	3532'				
Total Depth	3586'	3578'				

Describe in detail the manner in which the well was plugged, indicating where the mud fluid was placed and the method or methods used in introducing it into the hole. If cement or other plugs were used, state the character of same and depth placed, from feet to feet for each plug set.

Bottom plug set at 270 feet with 20 sacks of cement on top;
top plug set at 35 feet with 10 sacks of cement on top;
hole filled to top of cellar.

RECEIVED
STATE CORPORATION COMMISSION
APR 24 1952
CONSERVATION DIVISION
Wichita, Kansas

(If additional description is necessary, use BACK of this sheet)

Name of Plugging Contractor Northern Pump Company
Address Box 317, Great Bend, Kansas

STATE OF Kansas, COUNTY OF Barton, ss.

Chas. J. Bau (employee of owner) or (owner or operator) of the above-described well,
being first duly sworn on oath, says: That I have knowledge of the facts, statements, and matters herein contained and the log of the above-described well as filed and that the same are true and correct. So help me God.

(Signature)

Chas. J. Bau, General Manager
Box 317, Great Bend, Kansas
(Address)


SUBSCRIBED AND SWORN to before me this 23 day of April, 1952

My commission expires October 23, 1954

Notary Public.

23-8390-s

6-51-20M

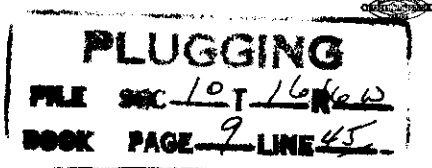

Company:
Northern Pump Company
Box 317
Great Bend, Kansas

Northern Pump Company
Hopkins #1
NE SW NW Sec. 10-T16S-R16W
Rush County, Kansas

Elevations: Ground 1958'
D.F. 1960'
K.B. 1963'

TOTAL DEPTH: 3586'
Commenced: April 2, 1952
Completed: April 19, 1952
Casing: 905' of 8-5/8" Surface Casing - Cemented with
450 sacks cement & 500# Calcium
Chloride

Figures indicate bottom of formation:

0	to	130	Surface Soil, Shale and Shells
130		370	Shale
370		500	Shale and Sand
500		520	Shale
520		725	Sand
725		790	Shale
790		965	Red bed and Shale
965		1000	Red Bed
1000		1100	Shale and Shells
1100		1415	Red Bed, Shale and Shells
1415		1770	Shale
1770		1860	Shale
1860		1985	Lime and Shale
1985		2125	Shale and Lime
2125		2200	Shale and Lime
2200		2265	Lime
2265		2335	Lime
2335		2375	Shale and Lime
2375		2490	Shale
2490		2640	Shale
2640		2750	Shale
2750		2820	Shale
2820		2905	Shale and Lime
2905		2993	Shale and Lime
2993		3043	Broken Lime
3043		3084	Lime and Shale
3084		3114	Lime
3114		3152	Lime
3152		3185	Lime
3185		3230	Lime and Shale
3230		3272	Lime
3272		3300	Lime
3300		3315	Lime
3315		3322	Lime
3322		3349	Lime
3349		3386	Lime
3386		3425	Lime
3425		3459	Lime
3459		3482	Lime and Shale
3482		3520	Conglomerate
3520		3530	Lime
3530		3533	Lime
3533		3536	Lime
3536		3539	Lime
3539		3547	Lime
3547		3586	Lime
		3586	Rotary Total Depth

RECEIVED
STATE OF KANSAS
APR 24 1952
CONSERVATION DIVISION
TOPEKA, KANSAS

Tops:
Topeka
Heebner
Lansing Ks. City
Base Ks. City
Conglomerate
Arbuckle (60)
Total Depth

Sample
2990 -1027
3192 -1229
3244 -1281
3450 -1487
3470 -1507
3526 -1563
3586

Schlumberger
2946
3166
3222
3452
3482
3532
3578

Dry & Abandoned

PLUGGING

FILE SEC 10 T 16 R
BOOK PAGE 9 LINE 45