


STATE OF KANSAS  
STATE CORPORATION COMMISSION

WELL PLUGGING RECORD

Give All Information Completely  
Make Required Affidavit  
Mail or Deliver Report to:  
Conservation Division  
State Corporation Commission  
P. O. Box 17027  
Wichita, Kansas 67217  
NORTH

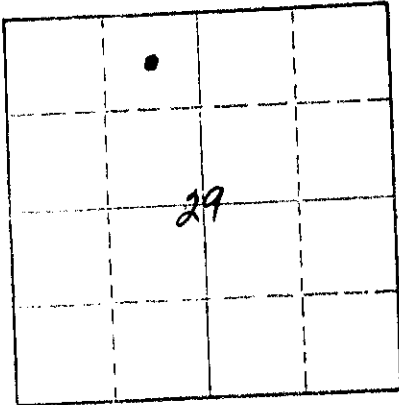

Locate well correctly on above  
Section Plat

Ness County. Sec. 29 Twp. 20 Rge. 24 (E) (W)  
Location as "NE/CNW/SE/SW" or footage from lines C-NE-NW  
Lease Owner TEXACO INC.  
Lease Name R. V. Lehner Heirs Well No. 1  
Office Address P. O. Box 2420, Tulsa, Okla.  
Character of Well (completed as Oil, Gas or Dry Hole) ASD  
Date well completed 8/28/74 19  
Application for plugging filed 6/20/75 19  
Application for plugging approved 6/30/75 19  
Plugging commenced 8/26/75 19  
Plugging completed 8/27/75 19  
Reason for abandonment of well or producing formation DRY

If a producing well is abandoned, date of last production - 19  
Was permission obtained from the Conservation Division or its agents before plugging was commenced?

Name of Conservation Agent who supervised plugging of this well Leo Massey  
Producing formation none Depth to top Bottom Total Depth of Well TD 4551' Feet  
PB 4494'  
Show depth and thickness of all water, oil and gas formations.

CASING RECORD

OIL, GAS OR WATER RECORDS			CASING RECORD			
FORMATION	CONTENT	FROM	TO	SIZE	PUT IN	PULLED OUT
				8-5/8"	320'	none
				5 1/2"	4551'	none

Describe in detail the manner in which the well was plugged, indicating where the mud fluid was placed and the method or methods used in introducing it into the hole. If cement or other plugs were used, state the character of same and depth placed, from feet to feet for each plug set.  
Plugged back 4494-4400' w/25 sx cmt, 4400-600' w/native mud & 35 sx gel., 600-5' below surf w/50 sx cmt.

PLUGGING COMPLETE

RECEIVED  
STATE CORPORATION COMMISSION

SEP 05 1975

CONSERVATION DIVISION  
Wichita, Kansas

(If additional description is necessary, use BACK of this sheet)

Name of Plugging Contractor Halliburton Cementing Co.  
Address

STATE OF Oklahoma, COUNTY OF Tulsa, ss.  
N. E. MORTON (employee of owner) or (owner or operator) of the above-described well, being first duly sworn on oath, says: That I have knowledge of the facts, statements, and matters herein contained and the log of the above-described well as filed and that the same are true and correct. So help me God.

(Signature) N. E. Morton Oper. Supt.  
N. E. MORTON, Box 2420, Tulsa, Ok.  
(Address)

SUBSCRIBED AND SWORN TO before me this 3rd day of September, 1975

My commission expires 8/20/17, 1975

M. K. VANN  
MY COMMISSION EXPIRES  
NOVEMBER 17, 1975  
Notary Public.

COMPANY Texaco, Inc.

SEC. 29 T. 20S R. 24W

FARM R.V. Lehner Heirs Well No. 1

LOC. C NE NE

RIG. NO. 4

TOTAL DEPTH 4551


COUNTY Ness

COMM. 7-22-74

COMP. 8-4-74

KANSAS

CONTRACTOR Rains & Williamson Oil Co., Inc.

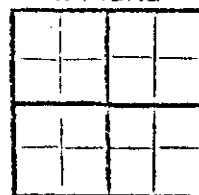

CASING

20 10  
15 8 5/8" @ 320' w/ 225 sx. common, 3% cc. ELEVATION  
12 6  
13 5 1/2" @ 4551' w/ 220 sx. HLC w/ 10# gilsonite PRODUCTION Oil  
per sx. + 200 sx. 50/50 w/ 18% salt per sx. & 3/4 x 1% CFR2  
FIGURES INDICATE BOTTOM OF FORMATIONS  
(Stage collar @ 2348' w/ 540 sx. HLC, w/ 10# gilsonite per sx.)

Surface Clay and Post Rock	30
Shale	320
Shale and Shells	790
Red Bed and Shale	870
Shale	1110
Sand	1325
Shale and Red Bed	1644
Anhydrite	1695
Shale and Lime	2300
Lime and Shale	2595
Shale and Lime	3040
Lime and Shale	3185
Shale and Lime	3455
Lime and Shale	3854
Shale and Lime	3905
Lime and Shale	4010
Lime	4551
Rotary Total Depth	4551

RECEIVED  
STATE CORPORATION COMMISSION

JUN 23 1975  
CONSERVATION DIVISION  
Wichita, Kansas

JUN 23 1975

State of Kansas }  
County of Sedgwick } ss:

I, Wilson Rains, President of the Rains & Williamson Oil Co., Inc. Company

upon oath state that the above and foregoing is a true and correct copy of the log of the R.V. Lehner Heirs Well #1 well.

Wilson Rains  
WILSON RAINS

Subscribed and sworn to before me this 7th day of August 19 74

Juanita M. Green  
NOTARY PUBLIC  
Juanita M. Green

My Commission Expires: October 4, 1975

