


STATE OF KANSAS
STATE CORPORATION COMMISSION

Give All Information Completely
Make Required Affidavit
Mail or Deliver Report to:
Conservation Division
State Corporation Commission
212 No. Market
Wichita, Kansas

WELL PLUGGING RECORD

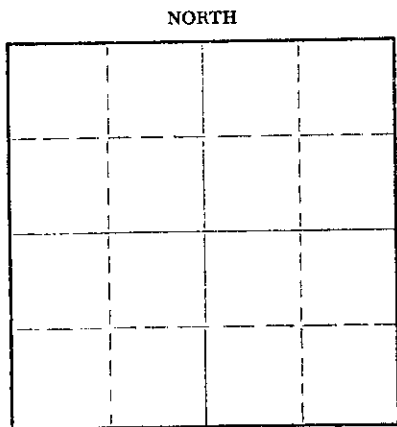

Locate well correctly on above
Section Plat

Ness County. Sec. 30 Twp. 20S Rge. (E) 24 (W)
Location as "NE/CNWxSWx" or footage from lines C/NW NE
Lease Owner R. V. Lehner
Lease Name Fercking "A" Well No. 1
Office Address P. O. Box 398, Ness City, Kansas 67560
Character of Well (completed as Oil, Gas or Dry Hole) Dry Hole
Date well completed April 23 19 69
Application for plugging filed April 23 19 69
Application for plugging approved April 23 19 69
Plugging commenced April 23 19 69
Plugging completed April 23 19 69
Reason for abandonment of well or producing formation Dry Hole

If a producing well is abandoned, date of last production 19
Was permission obtained from the Conservation Division or its agents before plugging was commenced? Yes

Name of Conservation Agent who supervised plugging of this well Leo Massey, Hays, Kansas
Producing formation Depth to top Bottom Total Depth of Well 4475 Feet
Show depth and thickness of all water, oil and gas formations.

OIL, GAS OR WATER RECORDS

CASING RECORD

FORMATION	CONTENT	FROM	TO	SIZE	PUT IN	PULLED OUT
	8-5/8"	0	288'			

Describe in detail the manner in which the well was plugged, indicating where the mud fluid was placed and the method or methods used in introducing it into the hole. If cement or other plugs were used, state the character of same and depth placed, from feet to feet for each plug set.
Plugged hole as follows: Plugged at 770' with 70 sacks of cement; plugged at 270' with 20 sacks of cement; plugged at 40' with 10 sacks of cement. Plug down at 3:20 P. M. April 23, 1969.

RECEIVED
STATE CORPORATION COMMISSION
APR 25 1969
CONSERVATION DIVISION
Wichita, Kansas


(If additional description is necessary, use BACK of this sheet)

Name of Plugging Contractor Strata Drilling, Inc.
Address P. O. Box 355, Great Bend, Kansas 67530

STATE OF KANSAS, COUNTY OF BARTON, ss.
Charles W. Steincamp (employee of owner) or (owner) of the above-described well, being first duly sworn on oath, says: That I have knowledge of the facts, statements, and matters herein contained and the log of the above-described well as filed and that the same are true and correct. So help me God.

(Signature) Charles W. Steincamp
Charles W. Steincamp
P. O. Box 355, Great Bend, Kansas 67530
(Address)

Subscribed and Sworn to before me this 24th day of April, 19 69
Elaine H. Taylor
Notary Public.

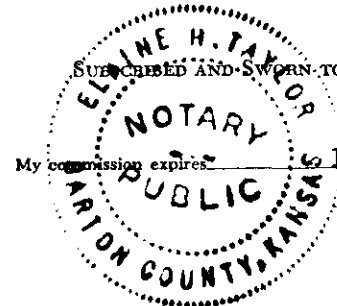

D R I L L E R S L O G

#1 Fercking "A"

CASING RECORD: 288' of new 8-5/8" surface casing.	COMPANY: R. V. Lehner	DESCRIPTION: C/NW NE Section 30-20S-24W Ness County, Kansas
TOTAL DEPTH: 4475'	CONTRACTOR: Strata Drilling, Inc.	ELEVATION: 2376' KB
	COMMENCED: April 12, 1969	
	COMPLETED: April 23, 1969	

D. & A.

<u>FORMATION</u>	<u>FROM</u>	<u>TO</u>	<u>REMARKS</u>
Shale	0	308	Ran 288' of new 8-5/8" surface casing; set and cemented at 288' with 165 sacks of regular cement and 2% gel. Plug down at 5:30 P. M. April 13, 1969.
Shale & Shells	308	1585	
Broken Lime, Shale & Red Bed	1585	1634	
Anhydrite	1634	1670	
Bed Bed, Shale & Broken Lime	1670	2110	
Shale & Lime	2110	4059	
Lime	4059	4170	
Lime & Shale	4170	4241	
Lime	4241	4390	
Lime & Chert	4390	4455	
Cherty Lime	4455	4465	
Chert & Lime	4465	4475	

Total Depth 4475'

D. & A.

Plugged hole as follows: Plugged at 770' with 70 sacks of cement; plugged at 270' with 20 sacks of cement; plugged at 40' with 10 sacks of cement. Plug down at 3:20 P. M. April 23, 1969.

STATE OF KANSAS)
) ss.
COUNTY OF BARTON)


RECEIVED
STATE CORPORATION COMMISSION
APR 25 1969
CONSERVATION DIVISION
Wichita, Kansas

I certify that this is a true and correct copy of the above log to the best of my knowledge.

STRATA DRILLING, INC.

Charles W. Steincamp
Charles W. Steincamp, President

Subscribed and sworn to before me this 24th day of April, 1969.
My Commission Expires:
December 14, 1969

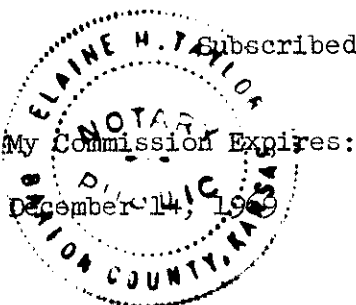

Elaine H. Taylor
Elaine H. Taylor, Notary Public