

15-135-20206-0000

STATE OF KANSAS
STATE CORPORATION COMMISSION

Form CP-4

Give All Information Completely
Make Required Affidavit
Mail or Deliver Report to
Conservation Division
State Corporation Commission
214 No. Market
Wichita, Kansas

WELL PLUGGING RECORD

Ness County, Sec. 30 Twp. 20 Rge. 24 (E) (W) X

Location as "NE/CNWSW" or footage from lines C SE SE

Lessee Owner R. V. Lehner Estate

Lessee Name Fercking Well No. 1

Office Address P. O. Box 342 Great Bend, Kansas 67530

Character of Well (completed as Oil, Gas or Dry Hole)

Date well completed 19

Application for plugging filed 1-28-71 19

Application for plugging approved 1-29-71 19


Plugging commenced 2-1-71 19

Plugging completed 2-16-71 19

Reason for abandonment of well or producing formation

If a producing well is abandoned, date of last production 19

Was permission obtained from the Conservation Division or its agents before plugging was commenced? Yes

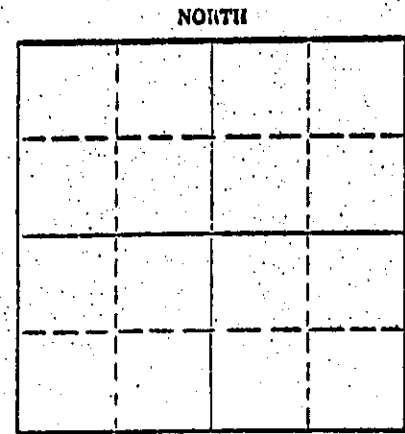

Locate well correctly on above Section Flat

Name of Conservation Agent who supervised plugging of this well Leo Massey

Producing formation Depth to top Bottom Total Depth of Well 4440 Feet

Show depth and thickness of all water, oil and gas formations.

OIL, GAS OR WATER RECORDS

CASING RECORD

FORMATION	CONTENT	FROM	TO	SIZE	PUT IN	PULLED OUT
				8 5/8	288	None
				4 1/2	4432	2906' 20

Describe in detail the manner in which the well was plugged, indicating where the mud fluid was placed and the method or methods used in introducing it into the hole. If cement or other plugs were used, state the character of same and depth placed, from feet to feet for each plug set.

Sanded off bottom to 4400' and dumped 4 sacks of cement. Shot casing at 3400', 3300' and 3200'. Shot casing at 3100', 3000' and 2900'. Laid down 93 joints. Found hole in 34th joint. Halliburton squeezed well with 3 sacks of hulls, 20 sacks of gel and 120 sacks of 50/50 pozmix cement with 6% added.

RECEIVED
STATE CORPORATION COMMISSION
MAR 1 1971
CONSERVATION DIVISION
Wichita, Kansas


(If additional description is necessary, use BACK of this sheet)
Name of Plugging Contractor Forbes Casing Pulling Company, Inc.
Address P. O. Box 221 Great Bend, Kansas 67530

STATE OF Kansas COUNTY OF Barton ss.
James W. Rockhold (employee of owner) or (owner or operator) of the above-described

well, being first duly sworn on oath, says: That I have knowledge of the facts, statements, and matters herein contained and the log of the above-described well is filed and that the same are true and correct. So help me God.

(Signature) James W. Rockhold
P. O. Box 221 Great Bend, Kansas 67530
(Address)

Subscribed and sworn to before me this 8 day of March 1971

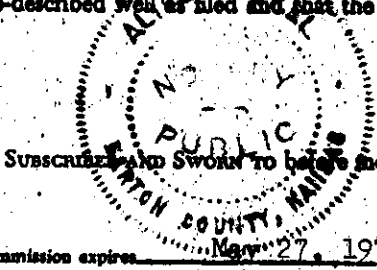

(Signature) Notary Public

My commission expires May 27, 1973

DRILLERS LOG

Oil Pooling

CASING RECORD:
283.12' of new 8-5/8"
surface casing.

COMPANY: R. V. Lahmer
CONTRACTOR: Strata Drilling, Inc.
COMMENCED: November 7, 1969
COMPLETED: November 17, 1969

SECTION: C/3E SE
Section 30-20N-24W
ELEVATION: 2345' DF

TOTAL DEPTH:
4440'

<u>FORMATION</u>	<u>FROM</u>	<u>TO</u>	<u>REMARKS</u>
Clay, Post Rock, Sand & shale	0	315	For 283.12' of new 8-5/8" surface casing; set and cemented at 283.12' with 185 sacks of regular cement and 27 gal. Plug down at 11:50 P. M. November 7, 1969.
shale	315	315	
Shale, Red Bed & Gypsum	325	340	
anhydrite	350	357	
Red Bed, shells & shale	357	1005	
Dakota Sand	1005	1205	
Red Bed, shells & shale	1205	1210	
Red Bed and shale	1510	1533	
anhydrite	1603	1617	
Red Bed, shale w/broken lime	1617	1920	
shale & lime	1930	4355	
Cherty Lime	4355	4440	

Total Depth 4440'

RECEIVED
STATE CORPORATION COMMISSION
JAN 29 1971
CONSERVATION DIVISION
Wichita, Kansas

4 1/2" O. D. casing set and cemented at 4432' with 160 sacks of 60-40 poe mix, salt saturated.

STATE OF KANSAS)
) ss.
COUNTY OF BARTON)

I certify that this is a true and correct copy of the above log to the best of my knowledge.

STRATA DRILLING, INC.

Charles W. Steinberg
Charles W. Steinberg, President

Subscribed and sworn to before me this 18th day of November, 1969.

My Commission Expires:
December 14, 1969

Elaine H. Taylor, Notary Public