


STATE OF KANSAS
STATE CORPORATION COMMISSION
CONSERVATION DIVISION
P. O. BOX 17027
WICHITA, KANSAS 67217

FORM CP-4

WELL PLUGGING RECORD

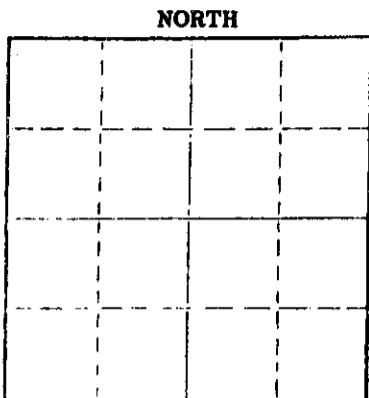

Locate well correctly on above Section Plat

Ness County, Sec. 31 Twp. 20S Rge. (E) 24(W)
Location as "NE/CNVKSW" or footage from lines E/2 SE NW
Lease Owner ZORGER OIL COMPANY
Lease Name Roth Well No. 1
Office Address 706 Union National Bldg., Wichita, Kans.
Character of Well (completed as Oil, Gas or Dry Hole) Dry Hole
Date well completed 2-4 1976
Application for plugging filed 2-4 1976
Application for plugging approved 2-4 1976
Plugging commenced 2-4 1976
Plugging completed 2-4 1976
Reason for abandonment of well or producing formation No commercial quantities of oil or gas encountered.
If a producing well is abandoned, date of last production 19
Was permission obtained from the Conservation Division or its agents before plugging was commenced? Yes

Name of Conservation Agent who supervised plugging of this well Gilbert Balthazor
Producing formation _____ Depth to top _____ Bottom _____ Total Depth of Well 4477 feet
Show depth and thickness of all water, oil and gas formations.

OIL, GAS OR WATER RECORDS

CASING RECORD

FORMATION	CONTENT	FROM	TO	SIZE	PUT IN	PULLED OUT
Surface Hole	Water	Surf.	325	8-5/8"	318	None

Describe in detail the manner in which the well was plugged, indicating where the mud fluid was placed and the method or methods used in introducing it into the hole. If cement or other plugs were used, state the character of same and depth placed, from _____ feet to _____ feet for each plug set.

Fluid to 720', plug, 70 sx cement;
Fluid to 300', plug, 20 sx cement;
Fluid to 40', plug, 1/2 sx hulls, 10 sx cement;

Name of Plugging Contractor D N B DRILLING, INC. (If additional description is necessary, use BACK of this sheet)
Address 701 First National Building
Wichita, Kansas 67202

STATE OF KANSAS COUNTY OF _____ ss.

JAMES L. DONELSON

(employee of owner) or (owner or operator) of the above-described well, being first duly sworn on oath, says: That I have knowledge of the facts, statements, and matters herein contained and the log of the above-described well as filed and that the same are true and correct. So help me God.

(Signature) James L. Donelson

701 First Nat'l Bldg., Wichita, Ks. 67202 (Address)

Subscribed and sworn to before me this 16th day of Feb. 1976

Ella Priess

My commission expires 8-25-76

Ella Priess Notary Public.

RECEIVED
FEB 17 1976
CONSERVATION DIVISION
Wichita, Kansas

Ella Priess
STATE NOTARY PUBLIC
Sedgwick County, Kansas
My Com. Expires Aug. 25, 1976

KS 135-2157-0000

RECEIVED
STATE CORPORATION COMMISSION

DRILLERS' LOG

FEB 17 1976

ZORGER OIL COMPANY
No. 1 Roth
E/2 SE NW, Sec. 31-20S-24W
Ness County, Kansas

CONSERVATION DIVISION
Wichita, Kansas

Elev: 2365 K.B.

Commenced: 1-26-76
Completed: 2- 5-76

Surface Casing: 318' of
8-5/8" cemented w/200 sx
common cement, 2% Gel 3% cc.
1-26-76

<u>FORMATION</u>	<u>DEPTH</u>
Surface Hole	0 - 325
Shale	325 - 1012
Blaine Anhydrite	1012 - 1024
Shale & Sand	1024 - 1452
Shale & Red Bed	1452 - 1632
Anhydrite	1632 - 1671
Shale	1671 - 2085
Shale & Lime	2085 - 2600
Lime & Shale	2600 - 3465
Lime	3465 - 3655
Lime & Shale	3655 - 3820
Lime	3820 - 4477 RTD

I do hereby certify that the foregoing statements are true and correct to the best of my knowledge and belief.

D N B DRILLING, INC.

James L. Donelson
JAMES L. DONELSON

STATE OF KANSAS: ss:

Subscribed and sworn to before me this 16th day of February, 1976.

Ella Priess

Ella Priess, Notary Public

 | *Ella Priess* |
 | STATE NOTARY PUBLIC |
 | Sedgwick County, Kansas |
 | My Com. Expires Aug. 25, 1976 |
