


STATE OF KANSAS
STATE CORPORATION COMMISSION
CONSERVATION DIVISION
P. O. BOX 17027
WICHITA, KANSAS 67217

FORM CP-4

WELL PLUGGING RECORD

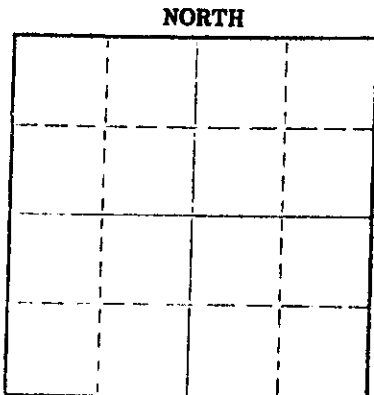

Locate well correctly on above Section Plat

_____ Ness _____ County. Sec. 31 Twp. 20S Rge. (E) 24(W)
Location as "NE/CNWSW" or footage from lines E/2 SE NW
Lease Owner ZORGER OIL COMPANY
Lease Name Roth Well No. 1
Office Address 706 Union National Bldg., Wichita, Kans.
Character of Well (completed as Oil, Gas or Dry Hole) Dry Hole
Date well completed _____
Application for plugging filed 2-4 19 76
Application for plugging approved 2-4 19 76
Plugging commenced 2-4 19 76
Plugging completed 2-4 19 76
Reason for abandonment of well or producing formation No commercial quantities of oil or gas encountered.
If a producing well is abandoned, date of last production _____
Was permission obtained from the Conservation Division or its agents before plugging was commenced? Yes

Name of Conservation Agent who supervised plugging of this well Gilbert Balthazor
Producing formation _____ Depth to top _____ Bottom _____ Total Depth of Well 4477
Show depth and thickness of all water, oil and gas formations.

OIL, GAS OR WATER RECORDS

CASING RECORD

FORMATION	CONTENT	FROM	TO	SIZE	PUT IN	PULLED OUT
<u>Surface Hole</u>	<u>Water</u>	<u>Surf.</u>	<u>325</u>	<u>8-5/8"</u>	<u>318</u>	<u>None</u>

Describe in detail the manner in which the well was plugged, indicating where the mud fluid was placed and the method or methods used in introducing it into the hole. If cement or other plugs were used, state the character of same and depth placed, from _____ feet to _____ feet for each plug set.

Fluid to 720', plug, 70 sx cement;
Fluid to 300', plug, 20 sx cement;
Fluid to 40', plug, 1/2 sx hulls, 10 sx cement;

FEB 23 1976

Name of Plugging Contractor D N B DRILLING, INC.
Address 701 First National Building
Wichita, Kansas 67202
STATE OF KANSAS COUNTY OF _____, ss.

JAMES L. DONELSON (employee of owner) or (owner or operator) of the above-described well, being first duly sworn on oath, says: That I have knowledge of the facts, statements, and matters herein contained and the log of the above-described well as filed and that the same are true and correct. So help me God.

(Signature) James L. Donelson
701 First Nat'l Bldg., Wichita, Ks. 67202
(Address)

SUBSCRIBED AND SWORN TO before me this 16th day of Feb. 19 76

My commission expires 8-25-76
Ella Priess Notary Public.

Ella Priess
STATE NOTARY PUBLIC
Sedgwick County, Kansas
My Com. Expires Aug. 25, 1976