


STATE OF KANSAS
STATE CORPORATION COMMISSION

Give All Information Completely
Make Required Affidavit
Mail or Deliver Report to:
Conservation Division
State Corporation Commission
P. O. Box 17027
Wichita, Kansas 67217
NORTH

WELL PLUGGING RECORD

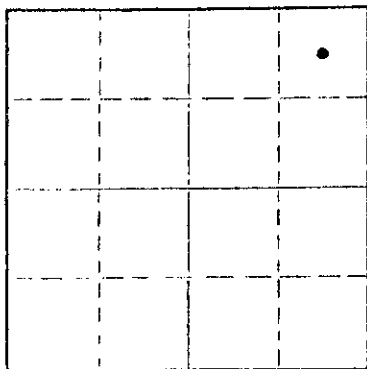

Locate well correctly on above
Section Plat

Wichita County, Sec. 11 Twp. 19S Rge. 37 (E) (W) X
 Location as "NE/CNW&SW" or footage from lines. C NE NE
 Lease Owner R. J. Patrick
 Lease Name Palkowitsh Well No. 1
 Office Address Box 1273, Liberal, Ks 67901
 Character of Well (completed as Oil, Gas or Dry Hole) Dry Hole
 Date well completed 11-9 1972
 Application for plugging filed 3-22 1975
 Application for plugging approved 3-24 1975
 Plugging commenced 4-1 1975
 Plugging completed 4-4 1975
 Reason for abandonment of well or producing formation _____

If a producing well is abandoned, date of last production _____ 19____
 Was permission obtained from the Conservation Division or its agents before plugging was commenced? Yes

Name of Conservation Agent who supervised plugging of this well Gilbert Baltozar
 Producing formation _____ Depth to top _____ Bottom _____ Total Depth of Well 2590 Feet
 Show depth and thickness of all water, oil and gas formations.

OIL, GAS OR WATER RECORDS

CASING RECORD

FORMATION	CONTENT	FROM	TO	SIZE	PUT IN	PULLED OUT
				7"	2590	1740
				10 3/4	304	none

Describe in detail the manner in which the well was plugged, indicating where the mud fluid was placed and the method or methods used in introducing it into the hole. If cement or other plugs were used, state the character of same and depth placed, from _____ feet to _____ feet for each plug set.

Pump 25 sks. of cement & 2 sks. of hulls to 2500'
 Pump 3 sks. of gel & 35 sks. of cement from 900 to 750'
 Pump 4 sks. of gel & 50 sks. of cement from 350 to 250'
 Put 3 sks. of gel, 1 sk. of hulls & 15 sks. of cement from 30 to 0'

RECEIVED
STATE CORPORATION COMMISSION

APR 14 1975
4-14-75
CONSERVATION DIVISION
Wichita, Kansas

(If additional description is necessary, use BACK of this sheet)

Name of Plugging Contractor Sargents Casing Pulling Service
 Address Box 506 Liberal, Kansas 67901

STATE OF _____ COUNTY OF _____ ss.


_____, (employee of owner) or (owner or operator) of the above-described well, being first duly sworn on oath, says: That I have knowledge of the facts, statements, and matters herein contained and the log of the above-described well as filed and that the same are true and correct. So help me God.

(Signature) R. J. Patrick

(Address) _____

SUBSCRIBED AND SWORN to before me this 11th day of April, 1975

My commission expires _____

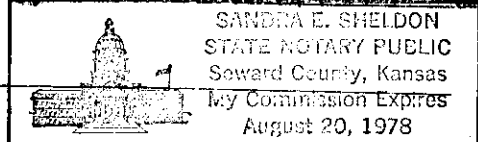

Sandra E. Sheldon
Notary Public.

Handwritten notes:
P. O. Box 129
Sterling, Kansas 67579

15-203-20017-0000

STERLING DRILLING COMPANY
P. O. Box 129
Sterling, Kansas 67579

WELL LOG ----- PALKOWITSH #1
Located: C NE NE, Section 11-19S-37W, Wichita County, Kansas

OWNER: Galaxy Oil Company
ROTARY DRILLING CONTRACTOR: Sterling Drilling Company

COMMENCED: November 5, 1972
COMPLETED: November 9, 1972

TOTAL DEPTH: 2590'

<u>LOG</u>	<u>CASING RECORD</u>
0 - 30 Surface Clay	Ran 9 joints 10 3/4" .3275# casing and one 15' landing joint. 311.70' landed 10 3/4" at 304.70 K.B. Cemented with 275 sacks Common Cement with 2% cc. Plug down 9:40 AM, 11-5-72.
30 - 45 Sand	
45 - 1230 Shale	
1230 - 1930 Sand and Shale	Ran 63 joints J-55 7" 26# and 23# casing, 2591.99' cemented at 2590' K.B. with 125 sacks Type H Cement with 3/4 of 1% T.I.C. Plug down 8:00 PM, 11-8-72.
1930 - 2250 Shale and Anhy. Stringers	
2250 - 2662 Sand, Shale and Lime	
2662 - 2391 Anhydrite	
2391 - 2510 Shand and Sand	
2510 - 2590 Shale and Anhy. Stringers	

RECEIVED
STATE CORPORATION COMMISSION

MAR 25 1975

CONSERVATION DIVISION
Wichita, Kansas