


STATE OF KANSAS
STATE CORPORATION COMMISSION

WELL PLUGGING RECORD

Give All Information Completely
Make Required Affidavit
Mail or Deliver Report to
Conservation Division
State Corporation Comm.
245 North Water
Wichita, KS 67202

Wichita County, Sec. 15 Twp. 19 Rge. 37 ~~XX~~/W
Location as "NE/CNW/SW" or footage from lines
C-NE 1/4

Lease Owner Osborn Heirs Co.
Lease Name APPL Well No. 1
Office Address Box 17968, San Antonio, TX 78286
Character of Well (Completed as Oil, Gas or Dry Hole)

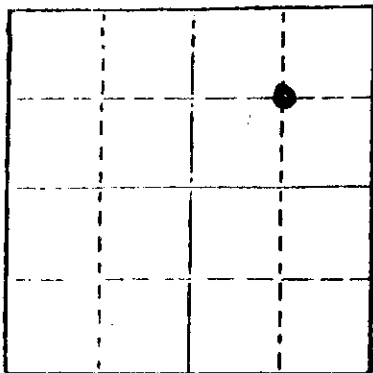

Locate well correctly on above
Section Plot

Gas
Date Well completed 8-31-81 19
Application for plugging filed 8-23-82 19
Application for plugging approved 8-27-82 19
Plugging commenced 9-14-82 19
Plugging completed 9-14-82 19
Reason for abandonment of well or producing formation
Non commercial Value

If a producing well is abandoned, date of last production
None 19

Was permission obtained from the Conservation Division or
its agents before plugging was commenced? yes

Name of Conservation Agent who supervised plugging of this well Mr. Tarbutton
Producing formation Hugoton Depth to top 2760' Bottom 2772' Total Depth of Well 2833'
Show depth and thickness of all water, oil and gas formations.

OIL, GAS OR WATER RECORDS

CASING RECORD

FORMATION	CONTENT	FROM	TO	SIZE	PUT IN	PULLED OUT
Surface				8 5/8"	331'	0'
Production				5 1/2"	2833'	0'

Describe in detail the manner in which the well was plugged, indicating where the mud fluid
was placed and the method or methods used in introducing it into the hold. If cement or other
plugs were used, state the character of same and depth placed, from _____ feet to
_____ feet for each plug set.

Pumped 3 sks. hulls, 5 sks. gel, 70 sks. cement, 1 sk hulls
5 sks. gel & 80 sks. cement 2760' to 0' pressured to 750 lbs.
Cut off 8 5/8" & 5 1/2", 3' below ground level

(If additional description is necessary, use BACK of this sheet)

Name of Plugging Contractor Midwest Casing Pulling Service

STATE OF KANSAS COUNTY OF HASKELL, ss.
I, Edgar J. Eves (~~owner~~) or (owner or operator)
of the above-described well, being first duly sworn on oath, says: That I have knowledge of
the facts, statements, and matters herein contained and the log of the above-described well
as filed and that the same are true and correct. So help me, God.

(Signature) Edgar J. Eves
Box F Sublette, Ks. 67877
(Address)

SUBSCRIBED AND SWORN TO before me this 24th day of Sept, 1982

Sandra L Eves
Notary Public.

My commission expires 12-6-82

OCT 06 1982
10-6-82
WICHITA, KANSAS

