

STATE OF KANSAS
STATE CORPORATION COMMISSION
200 Colorado Derby Bldg.
Wichita, Kansas 67202

Form CP-4
Rev. 12-15-80

WELL PLUGGING RECORD

Give All Information Completely
Make Required Affidavit

COUNTY Wichita SEC. 18 TWP. 19S RGE. 37 E/W
Location as in quarters or footage from lines:
NW-SE-SW 990 fsl 1500 fw1

Lease Owner Westburne Petroleum Inc.
Lease Name Fairchild Well No. 1-18
Office Address 999 18th St. St. 308 Denver, Co. 80202
Character of Well (Completed as Oil, Gas or Dry Hole): Dry hole
Date Well Completed 10-29-83
Application for plugging filed 10-27-83
Plugging commenced 10-28-83 9:30 PM
Plugging completed 10-29-83 5:45 AM
Reason for abandonment of well or producing formation _____

Locate Well
correctly on above
Section Platt.

Dry hole
Was permission obtained from the Conservation Division or it's
Agent's before plugging was commenced? Yes


Name of Conservation Agent who supervised plugging of this well Richard Lacey
Producing formation _____ Depth to top _____ bottom _____ T.D. 6321
Show depth and thickness of all water, oil and gas formations.

OIL, GAS OR WATER RECORDS Casing Record

Formation	Content	From	To	Size	Put in	Pulled Out
		0	430	8-5/8	428	0
				Cemented with	300 sks.	

Describe in detail the manner in which the well was plugged, indicating where the mud fluid was placed and the method or methods used in introducing it into the hold. If cement or other plugs were used, state the character of same and depth placed, from _____ feet to _____ feet for each plug set.

Well plugged through drill pipe with 60/40 Pozmix 2% gel & 3% CC
50 sack plug at 2300'
50 " " " 1320
40 " " " 480
Plug at 40 with 10 sacks of cement
10 sacks in rat / mouse holes

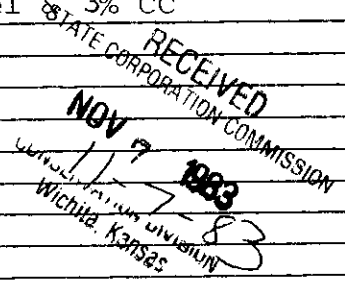

(If additional description is necessary, use BACK of this sheet)

Name of Plugging Contractor _____

STATE OF KANSAS COUNTY OF BARTON, ss.
WILLIAM J. LUCK (employee of owner) or (owner or operator) of the
above-described well, being first duly sworn on oath, says: That I have knowledge of the
facts, statements, and matters herein contained and the log of the above-described well as
filed and that the same are true and correct. So help me God.

(Signature) W J Luck
Box 1045 Great Bend Ks 67530
(Address)

SUBSCRIBED AND SWORN TO before me this 31st day of October, 1983

Niki Saffa
Notary Public.

My Commission expires: 