

STATE OF KANSAS  
STATE CORPORATION COMMISSION  
200 Colorado Derby Building  
Wichita, Kansas 67202

WELL PLUGGING RECORD  
K.A.R.-82-3-117

API NUMBER 15-171-20,392-0000

LEASE NAME REIFSCHNEIDER "P"

WELL NUMBER 1

TYPE OR PRINT  
NOTICE: Fill out completely  
and return to Cons. Div.  
office within 30 days.

1980 Ft. from S Section Line

640 Ft. from E Section Line

SEC. 16 TWP. 18S RGE. 31 (X) or (W)

COUNTY Scott

Date Well Completed 8-18-89

Plugging Commenced 8-18-89

Plugging Completed 8-18-89

LEASE OPERATOR SLAWSON EXPLORATION COMPANY, INC.

ADDRESS 104 S. BROADWAY, WICHITA, KANSAS 67202

PHONE# (316) 263-3201 OPERATORS LICENSE NO. 3988

Character of Well D&A

(Oil, Gas, D&A, SWD, Input, Water Supply Well)

The plugging proposal was approved on August 18, 1989 (date)

by Mike Spain (KCC District Agent's Name).

Is ACO-1 filled? by operator if not, is well log attached? yes

Producing Formation \_\_\_\_\_ Depth to Top \_\_\_\_\_ Bottom T.D. 4663'

Show depth and thickness of all water, oil and gas formations.

OIL, GAS OR WATER RECORDS

CASING RECORD

Formation	Content	From	To	Size	Put In	Pulled out
Surface		0	365	8 5/8"	365	none

Describe in detail the manner in which the well was plugged, indicating where the mud fluid was placed and the method or methods used in introducing it into the hole. If cement or other plugs were used, state the character of same and depth placed, from    feet to    feet each set.

100 sx. @ 2800', 50 sx. @ 2260, 80 sx. @ 1400', 40 sx. @ 400', 10 sx. @ 40', 15 sx. in rat hole  
Total 295 sx. 60/40 Pozmix, 6% Gel

(If additional description is necessary, use BACK of this form.)

Name of Plugging Contractor Allied Cementing License No. \_\_\_\_\_

Address P. O. Box 31 Russell, Kansas 67566

NAME OF PARTY RESPONSIBLE FOR PLUGGING FEES: SLAWSON EXPLORATION COMPANY, INC.

STATE OF KANSAS COUNTY OF BARTON, ss. 8-24-89

L. D. Davis agent (Employee of Operator) or (Operator)

above-described well, being first duly sworn on oath, says: That I have knowledge of the facts, statements, and matters herein contained and the log of the above-described well as filed that the same are true and correct, so help me God.

(Signature) L. D. Davis

(Address) L. D. Davis, Agent  
R.R. 1 Box 183 B

SUBSCRIBED AND SWORN TO before me this 23rd day of August, 19 89

Bessie M. DeWerff  
Notary Public

My Commission Expires: 5-20-93 Bessie M. DeWerff



FORM MUST BE TYPED  
FORM C-1 12/88

State of Kansas  
NOTICE OF INTENTION TO DRILL

FORM MUST BE SIGNED  
ALL BLANKS MUST BE FILLED

Must be approved by the K.C.C. five (5) days prior to commencing well

Expected Spud Date ... July ... 31st ... 1989 ...  
month day year

40 C NE SE Sec 16 Twp 18 S, Rg 31 X East West

OPERATOR: License # 3988  
Name: SLAWSON EXPLORATION COMPANY, INC.  
Address: 104 South Broadway, Suite 200  
City/State/Zip: Wichita, Kansas 67202-4165  
Contact Person: Jim Remsberg  
Phone: (316) 263-3201

1980' feet from South line of Section  
640' feet from East line of Section  
(Note: Locate well on Section Plat Below)

CONTRACTOR: License #: 6039  
Name: L. D. Drilling, Inc.

County: Scott  
Lease Name: Reifschneider Well #: 1  
Field Name: Wildcat  
Is this a Prorated Field? ... yes X no  
Target Formation(s): Mississippian  
Nearest lease or unit boundary: 660' 640'  
Ground Surface Elevation: 2928' GR. (Seis) feet MSL  
Domestic well within 330 feet: ... yes X no  
Municipal well within one mile: ... yes X no  
Depth to bottom of fresh water: 200'  
Depth to bottom of usable water: 1500'  
Surface Pipe by Alternate: 1 X 2  
Length of Surface Pipe Planned to be set: 365'  
Length of Conductor pipe required: None  
Projected Total Depth: 4625'  
Formation at Total Depth: Mississippian  
Water Source for Drilling Operations:

Well Drilled For: Well Class: Type Equipment:  
X oil ... Inj ... Infield X Mud Rotary  
... Gas ... Storage ... Pool Ext. ... Air Rotary  
... OAWO ... Disposal X Wildcat ... Cable  
... Seismic; ... # of Holes

If OAWO: old well information as follows:  
Operator: ...  
Well Name: ...  
Comp. Date: ... Old Total Depth: ...


Directional, Deviated or Horizontal wellbore? ... yes X no  
If yes, total depth location: ...

X well ... farm pond ... other  
DWR Permit #: 889045  
Will Cores Be Taken? ... yes X no  
If yes, proposed zone: ...

200' Alt. II Req.

AFFIDAVIT

PUSHER Greg Davidson  
TD 4663 FORMATION Miss  
SURFACE PIPE 8 @ 365  
ANHYDRITE 2246 ELEVATION 2933  
STARTING TIME & DATE 12:30 am 8-20-89  
COMPLETION TIME & DATE 3:00 am 8-20-89  
1st PLUG @ 3900 FT. W/ 100 SX  
2nd PLUG @ 2264 FT. W/ 50 SX  
3rd PLUG @ 1400 FT. W/ 80 SX  
4th PLUG @ 400 FT. W/ 40 SX  
RAT HOLE CIRCULATED W/ 40 10 SX  
MOUSE HOLE CIRCULATED W/ 15 SX  
WATER WELL PLUGGED W/ SX  
CEMENT COMPANY Allied  
TECHNICIAN RL  
TYPE OF CEMENT 60/40 6%

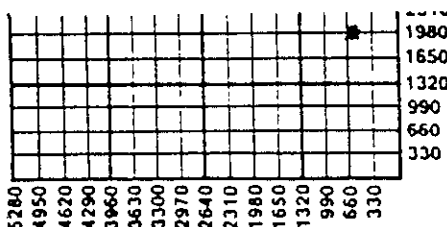

IN 1989

6 months of effective date.)  
Spud date: \_\_\_\_\_ Agent: \_\_\_\_\_

AUG 23 1989

- REMEMBER TO:
- File Drill Pit Application (form COP-1) with Intent to Drill;
  - File Completion Form ACO-1 within 120 days of spud date;
  - File acreage attribution plat according to field proration orders;
  - Notify appropriate district office 48 hours prior to workover or re-entry;
  - Submit plugging report (CP-4) after plugging is completed;
  - Obtain written approval before disposing or injecting salt water.