

STATE OF KANSAS
STATE CORPORATION COMMISSION

WELL PLUGGING RECORD

Give All Information Completely
Make Required Affidavit
Mail or Deliver Report to
Conservation Division
State Corporation Comm.
245 North Water
Wichita, KS 67202

Kiowa County, Sec. 2 Twp. 28S Rge. 20W ~~EA~~
Location as "NE/CNW/SW" or footage from lines
C SW NW

Lease Owner Lee Banks
Lease Name Price-Brensing Well No. 1

Office Address 200 W. Douglas, Suite 550, Wichita, KS 67202
Character of Well (Completed as Oil, Gas or Dry Hole)

Dry Hole

Date Well completed October 17, 1980
Application for plugging filed October 17, 1980
Application for plugging approved October 17, 1980
Plugging commenced October 17, 1980
Plugging completed October 17, 1980
Reason for abandonment of well or producing formation


Dry Hole

If a producing well is abandoned, date of last production 19

Was permission obtained from the Conservation Division or its agents before plugging was commenced? Yes

Name of Conservation Agent who supervised plugging of this well Wm. T. Owen
Producing formation Depth to top Bottom Total Depth of Well 4940'

Show depth and thickness of all water, oil and gas formations.

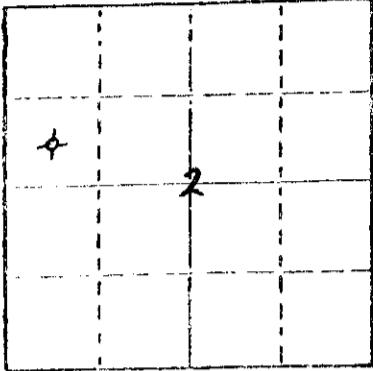

Locate well correctly on above Section Plot

OIL, GAS OR WATER RECORDS

CASING RECORD

| FORMATION | CONTENT | FROM | TO | SIZE | PUT IN | PULLED OUT |
|-----------|---------|------|------|--------|---------|------------|
| | | 0' | 603' | 8-5/8" | 596.54' | None |
| | | | | | | |
| | | | | | | |
| | | | | | | |

Describe in detail the manner in which the well was plugged, indicating where the mud fluid was placed and the method or methods used in introducing it into the hold. If cement or other plugs were used, state the character of same and depth placed, from feet to feet for each plug set.

Plugged with 50 sacks cement at 600';
10 sacks cement at 40'; and 10 sacks
cement in rat hole.

(If additional description is necessary, use PACK of this sheet)

Name of Plugging Contractor Allied Cementing Co.

STATE OF KANSAS COUNTY OF SEDGWICK
John D. Knightley Agent (employee of owner) or (owner or operator)
of the above-described well, being first duly sworn on oath, says: That I have knowledge of the facts, statements, and matters herein contained and the log of the above-described well as filed and that the same are true and correct. So help me God.

(Signature) [Signature]
221 S. Broadway Suite 400, Wichita, KS 67202
(Address)

SUBSCRIBED AND SWORN TO before me this 29th day of October, 1980

My commission expires March 12, 1983



[Signature]
Notary Public.

15-097-20682-0000

Lee Banks - Price-Brensing #1
200 W. Douglas, Suite 550 C SW NW Sec. 2-28S-20W
Wichita, Kansas 67202 Kiowa County, Kansas

Contractor: D. R. Lauck Oil Company, Inc.
221 S. Broadway, Suite 400
Wichita, Kansas 67202

Commenced: October 7, 1980
Completed: October 17, 1980

Drillers Log

| | |
|-------------------|----------|
| Sand & Native Mud | 104 |
| Native Mud | 606 |
| Red Bed & Shale | 2070 |
| Shale & Shells | 2335 |
| Shale | 2600 |
| Shale & Lime | 2840 |
| Shale | 3984 |
| Shale & Lime | 4320 |
| Lime | 4465 |
| Lime & Shale | 4842 |
| Lime | 4940 RTD |

STATE OF KANSAS
- OCT 30 1980
COUNTY OF KIOWA
Wichita, Kansas