


STATE OF KANSAS
STATE CORPORATION COMMISSION
200 Colorado Derby Bldg.
Wichita, Kansas 67202

WELL PLUGGING RECORD

Give All Information Completely
Make Required Affidavit

COUNTY Rush SEC. 7 TWP. 16S RGE. 16W ~~E/W~~
Location as in quarters or footage from lines:
N2 N2 Se

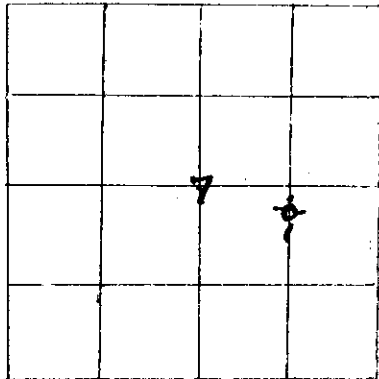

Locate Well
correctly on above
Section Platt.

Lease Owner Alpine Drilling Co., Inc.
Lease Name Stramel Well No. 1
Office Address 200 E. First, Suite 500, Wichita, KS 67202
Character of Well (Completed as Oil, Gas or Dry Hole): Dry Hole
Date Well Completed March 18, 1983
Application for plugging filed March 18, 1983
Plugging commenced March 18, 1983
Plugging completed March 18, 1983
Reason for abandonment of well or producing formation _____

Was permission obtained from the Conservation Division or it's
Agent's before plugging was commenced? yes

Name of Conservation Agent who supervised plugging of this well Bob Tarbutton
Producing formation _____ Depth to top _____ bottom T.D. 3554
Show depth and thickness of all water, oil and gas formations.

OIL, GAS OR WATER RECORDS

Casing Record

Formation	Content	From	To	Size	Put in	Pulled Out
Surface	shale	0	1080	8-5/8	977	none
	Cemented with 250 sx 60/40 posmix, and 200 sx common 2%gel, 3% cc, plug down at 4:45 a.m. 3-13-83 by Sun; cement did circulate					

Describe in detail the manner in which the well was plugged, indicating where the mud
fluid was placed and the method or methods used in introducing it into the hold. If cement
or other plugs were used, state the character of same and depth placed, from _____ feet
to _____ feet for each plug set.


Plugged as follows by Sun with 50/50 posmix, 2%gel, 3%cc
50 sx @ 3540'; 50 sx @ 1140'; 40 sx @ 570'; 10 sx @ 40' w/solid bridge
plug, 15 sx in rat hole thru drill pipe. Job completed at 7:45 a.m.
3-18-83

(If additional description is necessary, use BACK of this sheet)

Name of Plugging Contractor J. W. Drilling Co., Inc.

STATE OF KANSAS COUNTY OF SEDGWICK, ss.
Jon T. Williams, Jr. (employee of owner) or (owner or operator) of the
above-described well, being first duly sworn on oath, says: That I have knowledge of the
facts, statements, and matters herein contained and the log of the above-described well as
filed and that the same are true and correct. So help me God.

(Signature) [Signature]
200 E. First, Suite 500, Wichita, KS 67202
(Address)

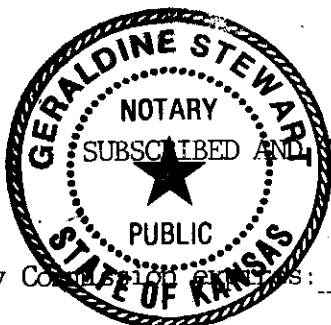

SWORN TO before me this 18th day of March, 19 83

Geraldine Stewart
Geraldine Stewart, Notary Public,
STATE CORPORATION COMMISSION

My Commission Expires: January 14, 1985

MAR 30 1983