

STATE CORPORATION COMMISSION OF KANSAS
OIL & GAS CONSERVATION DIVISION

WELL COMPLETION OR RECOMPLETION FORM
ACO-1 WELL HISTORY

DESCRIPTION OF WELL AND LEASE

Operator: license # 5181
name DONALD C. SLAWSON
address 200 Douglas Building
City/State/Zip Wichita, Kansas 67202

Operator Contact Person Bill Horigan
Phone 316-263-3201

Contractor: license # 5657
name SLAWSON DRILLING CO., INC.

Wellsite Geologist Charles Spradlin
Phone (316)683-0668

Designate Type of Completion
 New Well Re-Entry Workover
 Oil SWD Temp Abd
 Gas Inj Delayed Comp.
 Dry Other (Core, Water Supply etc.)

If OWWO: old well info as follows:
Operator
Well Name
Comp. Date Old Total Depth

WELL HISTORY

Drilling Method: Mud Rotary Air Rotary Cable
6-19-84 6-28-84 6-28-84
Spud Date Date Reached TD Completion Date
4470' 4470'
Total Depth PBD

Amount of Surface Pipe Set and Cemented at ... 389 ... feet
Multiple Stage Cementing Collar Used? Yes No
If Yes, Show Depth Set ... feet

If alternate 2 completion, cement circulated
from ... feet depth to ... w/ ... SX cmt

API NO. 15 - 101-20,995 - 0000
County Lane
NW NE NE Sec 11 Twp 16S Rge 30W

4950 Ft North from Southeast Corner of Section
990 Ft West from Southeast Corner of Section
(Note: locate well in section plat below)


Lease Name York 'KK' Well# 1

Field Name WC

Producing Formation

Elevation: Ground 2701 KB 2707

Section Plat

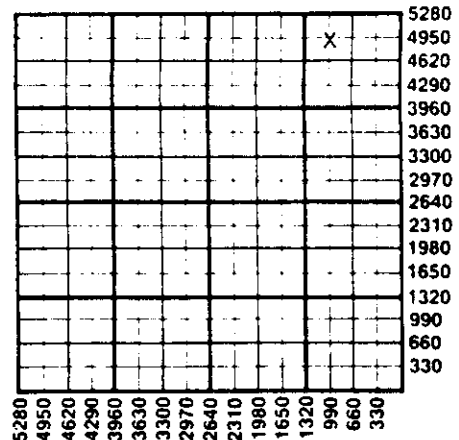

WATER SUPPLY INFORMATION

Source of Water:
Division of Water Resources Permit #
 Groundwater Ft North From Southeast Corner and
(Well) Ft. West From Southeast Corner o
Sec Twp Rge East West
 Surface Water Ft North From Southeast Corner and
(Stream, Pond etc.) Ft West From Southeast Corner
Sec Twp Rge East West
 Other (explain)
(purchased from city, R.W.D.#)

Disposition of Produced Water: Disposal Repressuring
Docket #

INSTRUCTIONS: This form shall be completed in duplicate and filed with the Kansas Corporation Commission, 200 Colorado Derby Building, Wichita, Kansas 67202, within 90 days after completion or recompletion of any well. Rules 82-3-130 and 82-3-107 apply.
Information on side two of this form will be held confidential for a period of 12 months if requested in writing and submitted with the form. See rule 82-3-107 for confidentiality in excess of 12 months.
One copy of all wireline logs and drillers time log shall be attached with this form. Submit CP-4 form with all plugged wells. Submit CP-111 form with all temporarily abandoned wells.

All requirements of the statutes, rules, and regulations promulgated to regulate the oil and gas industry have been fully complied with and the statements herein are complete and correct to the best of my knowledge.

Signature William R. Horigan
Title Kansas Operations Manager
Date

Subscribed and sworn to before me this 8th day of August 1984
Notary Public Leslie K. Robinson
Date Commission Expires 5-27-85

RECEIVED
STATE CORPORATION COMMISSION
AUG 16 1984
8-16-84
CONSERVATION DIVISION
Wichita, Kansas

K.C.C. OFFICE USE ONLY
 Letter of Confidentiality Attached
 Wireline Log Received
 Drillers Time log Received
Distribution
 KCC SWD/Rep NGPA
 KGS Plug Other
(Specify)

LESLIE K. ROBINSON
NOTARY PUBLIC
STATE OF KANSAS
EXPIRES 5-27-85

Form ACO-1
(This form supercedes
previous forms
ACO-1 & C-10)

Sec. 11, Twp. 16, Rge. 30W