

AFFIDAVIT AND COMPLETION FORM


ACO-1

This form must be filed in triplicate with the Kansas Corporation Commission, 200 Colorado Derby Building, Wichita, Kansas 67202, within five days after the completion of the well, regardless of how the well was completed. Circle one: Oil gas, dry, SWD, OWWO, injection. Please type. Complete ALL sections. Applications must be filed for dual completion, commingling, salt water disposal and injection. Attach wireline logs (i.e. electrical log, sonic log, gamma ray neutron log, etc.) KCC#-(316) 263-3238.

OPERATOR CHIEF DRILLING CO., INC. API NO. 101-20, 597-0000  
 ADDRESS 905 Century Plaza COUNTY Lane  
Wichita, Kansas FIELD ROEMER L.C.  
 \*\*CONTACT PERSON F.W. Shelton, Jr. LEASE ROEMER A-  
 PHONE 316-262-3791

PURCHASER Clear Creek WELL NO. #2  
 ADDRESS 818 Century Plaza WELL LOCATION 100' SE OF NE NW SW  
Wichita, Ks. 67202 330' Ft. from North Line and  
990' Ft. from East Line of  
 DRILLING CONTRACTOR Warrior Drilling Co. the SW/4 SEC. 13 TWP. 16S RGE. 30W

ADDRESS 905 Century Plaza  
Wichita, Kansas 67202  
 PLUGGING CONTRACTOR \_\_\_\_\_  
 ADDRESS \_\_\_\_\_  
 TOTAL DEPTH RTD 4411 PBTD \_\_\_\_\_  
 SPUD DATE 12-19-81 DATE COMPLETED 1-20-82  
 ELEV: GR 2811 DF 2815 KB 2818

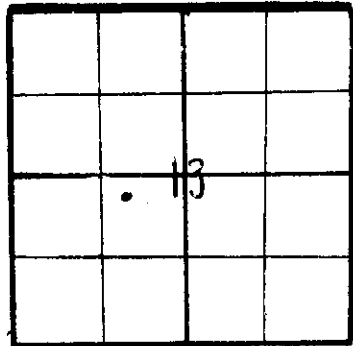

WELL PLAT  
 (Quarter) or (Full) Section - Please indicate.  
 KCC   
 KGS

DRILLED WITH ~~(CABLE)~~ (ROTARY) ~~(AIR)~~ TOOLS (New)/(used) casing.  
 Report of all strings set — surface, intermediate, production, etc.

Purpose of string	Size hole drilled	Size casing set (in O.D.)	Weight lbs/ft.	Setting depth	Type cement	Socks	Type and percent additives
	12 1/4	8 5/8	20#	327'	common quick set	200	
		4 1/2"					

LINER RECORD			PERFORATION RECORD		
Top, ft.	Bottom, ft.	Socks cement	Shots per ft.	Size & type	Depth interval
none	none	none	none	none	none
TUBING RECORD					
Size	Setting depth	Packer set at			
2 3/8	4,382.00	none			

Amount and kind of material used	Depth interval treated
acidized w/1500 gal. 15% reg.	4400 - 4411 O.H.

RECEIVED  
 STATE RECORDING COMMISSION  
 1-27-82  
 JAN 27 1982

TEST DATE:		PRODUCTION	
Date of first production	Producing method (flowing, pumping, gas lift, etc.)	A.P.I. Gravity	
1-20-82	Pumping		
RATE OF PRODUCTION PER 24 HOURS	Oil	Gas	Water
	85 bbls.	MCF	14 bbls.
Disposition of gas (vented, used on lease or sold)	Producing interval (s)		
VENTED	4400 - 4411		

\*\* The person who can be reached by phone regarding any questions concerning this information.  
 A witnessed initial test by the Commission is required if the well produces more than 25 BOPD or is located in a Basic Order Pool.

Name of lowest fresh water producing stratum Unknown Depth 550'  
 Estimated height of cement behind pipe \_\_\_\_\_

**WELL LOG**

Show all important zones of porosity and contents thereof; cored intervals, and all drill-stem tests, including depth interval tested, cushion used, time tool open, flowing and shut-in pressures, and recoveries.

SHOW GEOLOGICAL MARKERS, LOGS RUN, OR OTHER DESCRIPTIVE INFORMATION.

FORMATION DESCRIPTION, CONTENTS, ETC.	TOP	BOTTOM	NAME	DEPTH
DST #1 3972 - 4411 30-30 30-30 Strong blow diminishing to good for gas to surface 60", Rec. 1200' fluid, 750' clear gassy oil, 270' oil w/trace of mud, 140' muddy oil, 40' Muddy water IBHP: 825#, FBHP: 809#, FP: 157-504 RTD 4411			Anhydrite	2218 + 600
			Heebner	3878 - 1060
			Lansing	3914 - 1096
			Muncie Cr.	4081 - 1263
			Stark	4175 - 1357
			Hush Puckney	4203 - 1385
			BKC	4264 - 1446
			Pawnee	4363 - 1545
			Pawnee Poros	4400 - 1582

USE ADDITIONAL SHEETS, IF NECESSARY, TO COMPLETE WELL RECORD.

**A F F I D A V I T**

STATE OF KANSAS, COUNTY OF SEDGWICK SS,

F.W. SHELTON, JR. OF LAWFUL AGE, BEING FIRST DULY SWORN UPON HIS OATH, DEPOSES AND SAYS:

THAT HE IS VICE PRESIDENT FOR CHIEF DRILLING CO., INC. OPERATOR OF THE ROEMER A LEASE, AND IS DULY AUTHORIZED TO MAKE THIS AFFIDAVIT FOR AND ON BEHALF OF SAID OPERATOR, THAT WELL NO. #2 ON SAID LEASE HAS BEEN COMPLETED AS OF THE 20th DAY OF January 19 82, AND THAT ALL INFORMATION ENTERED HEREIN WITH RESPECT TO SAID WELL IS TRUE AND CORRECT.

FURTHER AFFIANT SAITH NOT.

(S) *F.W. Shelton, Jr.*  
 F.W. Shelton, Jr., Vice President  
 SUBSCRIBED AND SWORN TO BEFORE ME THIS 25th DAY OF January 19 82

*Martha E. Gustin*  
 NOTARY PUBLIC  
 Martha E. Gustin

MY COMMISSION EXPIRES: \_\_\_\_\_

