

SIDE ONE

STATE CORPORATION COMMISSION OF KANSAS
OIL & GAS CONSERVATION DIVISION
RECOMPLETION FORM
ACO-2 AMENDMENT TO WELL HISTORY

API NO. 15- 129-20,775 0001

County Morton

SE NW SW Sec 33 Twp 33S Rge 42 X East West

Operator: License # 6378
Name Hawkins Oil & Gas, Inc.
Address Box 1282
City/State/Zip Liberal, KS 67905-1282

1650 Ft North from Southeast Corner of Section
4290 Ft West from Southeast Corner of Section
(Note: Locate well in section plat below)

Purchaser Panda Resources

Lease Name McClain "A" Well # 1

Operator Contact Person Frank Gagliardi
Phone (918) 585-3121

Field Name Unnamed TACCOG A, North

Name of ~~NEW~~ Formation Morrow

Elevation: Ground 3441' KB 3453'
Section Plat

Designate Type of Original Completion
 New Well Re-Entry Workover

Oil SWD Temp Abd
 Gas Inj Delayed Comp.
 Dry Other (Core, Water Supply etc.)


Date of Original Completion: 12-24-85

DATE OF RECOMPLETION:
1-16-89 2-17-89
Commenced Completed

Designate Type of Recompletion/Workover:
 Deepening Delayed Completion

Plug Back Re-perforation
 Conversion to Injection/Disposal

Is recompleted production:
 Commingled; Docket No. _____
 Dual Completion; Docket No. _____
 Other (Disposal or Injection)?

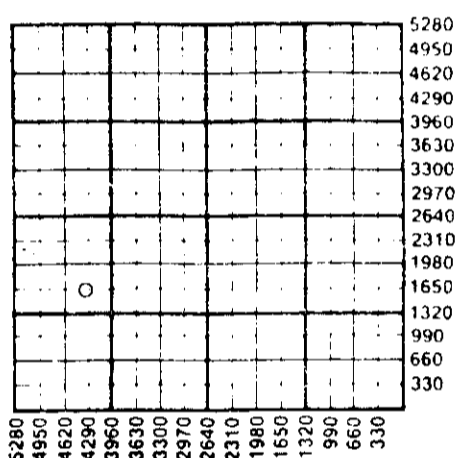

RECEIVED
STATE CORPORATION COMMISSION

APR 10 1989
04-1889
CONSERVATION DIVISION
Wichita, Kansas

K.C.C. OFFICE USE ONLY
 Letter of Confidentiality Attached
 Wireline Log Received
 Drillers Timelog Received
Distribution
 KCC SWD/Rep NGPA
 KGS Plug Other
(Specify)
.....
.....
4-1889

INSTRUCTIONS: This form shall be completed in triplicate and filed with the Kansas Corporation Commission, 200 Colorado Derby Building, Wichita, Kansas 67202, within 120 days of the recompletion of any well. Rules 82-3-107 and 82-3-141 apply. Information on side two of this form will be held confidential for a period of 12 months if requested in writing and submitted with the form. See rule 82-3-107 for confidentiality in excess of 12 months. One copy of any additional wireline logs and driller's time logs (not previously submitted) shall be attached with this form. Submit ACO-4 prior to or with this form for approval of commingling or dual completions. Submit CP-4 with all plugged wells. Submit CP-111 with all temporarily abandoned wells. NOTE: Conversion of wells to either disposal or injection must receive approval before use; submit form U-1.

All requirements of the statutes, rules and regulations promulgated to regulate the oil and gas industry have been fully complied with and the statements herein are complete and correct to the best of my knowledge.

Signature [Signature] Title Superintendent Date 4-10-89

Subscribed and sworn to before me this 10th day of April 19 89

Notary Public [Signature] Date Commission Expires 4-13-90
Jimmy Lee Barlow

