



CONFIDENTIAL

WELL COMPLETION FORM

WELL HISTORY - DESCRIPTION OF WELL & LEASE

OPERATOR: License # 34192
 Name: SandRidge Exploration and Production LLC
 Address 1: 123 ROBERT S. KERR AVE
 Address 2: _____
 City: OKLAHOMA CITY State: OK Zip: 73102 + 6406
 Contact Person: Tiffany Golay
 Phone: (405) 429-6543
 CONTRACTOR: License # 34464
 Name: Lariat Services, Inc.
 Wellsite Geologist: Joe Hileman
 Purchaser: DCP Midstream, LP (gas) NCRA (oil)

Designate Type of Completion:

- New Well Re-Entry Workover
- Oil WSW SWD SIOW
 Gas D&A ENHR SIGW
 OG GSW Temp. Abd.
 CM (Coal Bed Methane)
 Cathodic Other (Core. Expl., etc.): _____

If Workover/Re-entry: Old Well Info as follows:

Operator: _____
 Well Name: _____
 Original Comp. Date: _____ Original Total Depth: _____
 Deepening Re-perf. Conv. to ENHR Conv. to SWD
 Conv. to GSW
 Plug Back: _____ Plug Back Total Depth _____
 Commingled Permit #: _____
 Dual Completion Permit #: _____
 SWD Permit #: _____
 ENHR Permit #: _____
 GSW Permit #: _____

| | | |
|-----------------------------------|------------------|---|
| <u>9/4/2012</u> | <u>9/19/2012</u> | <u>9/22/2012</u> |
| Spud Date or Recompletion Date | Date Reached TD | Completion Date or Recompletion Date |

API No. 15 - 15-033-21667-01-00
 Spot Description: _____
S2 S2 SE NW Sec. 26 Twp. 31 S. R. 20 East West
2435 Feet from North / South Line of Section
1980 Feet from East / West Line of Section
 Footages Calculated from Nearest Outside Section Corner:
 NE NW SE SW
 County: Comanche
 Lease Name: Garland 3120 Well #: 1-26H
 Field Name: _____
 Producing Formation: Mississippian
 Elevation: Ground: 1966 Kelly Bushing: 1986
 Total Depth: 9254 Plug Back Total Depth: _____
 Amount of Surface Pipe Set and Cemented at: 325 Feet
 Multiple Stage Cementing Collar Used? Yes No
 If yes, show depth set: _____ Feet
 If Alternate II completion, cement circulated from: _____
 feet depth to: _____ w/ _____ sx crmt.

Drilling Fluid Management Plan

(Data must be collected from the Reserve Pit)

Chloride content: 38000 ppm Fluid volume: 140 bbls
 Dewatering method used: Hauled to Disposal
 Location of fluid disposal if hauled offsite: _____
 Operator Name: LoJo Disposal
 Lease Name: Pit #1 License #: 99999
 Quarter SW Sec. 10 Twp. 26 S. R. 15 East West
 County: Woods, OK Permit #: 563714

AFFIDAVIT

I am the affiant and I hereby certify that all requirements of the statutes, rules and regulations promulgated to regulate the oil and gas industry have been fully complied with and the statements herein are complete and correct to the best of my knowledge.

Submitted Electronically

KCC Office Use ONLY


- Letter of Confidentiality Received
 Date: 01/02/2013
 Confidential Release Date: _____
 Wireline Log Received
 Geologist Report Received
 UIC Distribution
 ALT I II III Approved by: NAOMI JAMES Date: 01/04/2013

| Directional Survey Calculations | Measured Depth (ft) | Sub-Sea Incl. (deg) | Vertical Azim. (ft) | True Vert Depth (ft) | Northings (+) Southings (-) (ft) | Eastings (+) Westings (-) (ft) | Vert Section (ft) | DLS deg/100' (deg) | FNL | FSL | FWL | FEL |
|---------------------------------|---------------------|---------------------|---------------------|----------------------|----------------------------------|--------------------------------|-------------------|--------------------|-------|------|------|------|
| | | | | | | | | | | | | |
| SHL | 0 | 0.00 | 0.00 | 0.00 | 0.00 | 0.00 | 0.00 | 0.00 | 2436 | 212 | 1980 | 3271 |
| BHL | 9254 | 89.60 | 3.90 | 5064.97 | 4533.76 | 128.15 | 4535.56 | 0.00 | -2099 | 4746 | 2023 | 3213 |
| Miss Entry | 5194 | 54.21 | 2.81 | 5000.23 | 495.18 | 27.28 | 495.78 | 11.16 | 1940 | 707 | 1998 | 3251 |
| Top Perf | 5316 | 69.43 | 3.33 | 5057.67 | 601.01 | 33.57 | 601.75 | 13.38 | 1834 | 813 | 2003 | 3247 |
| Bottom Perf | 9150 | 89.80 | 3.90 | 5064.34 | 4430.00 | 121.08 | 4431.64 | 0.95 | -1996 | 4643 | 2016 | 3218 |

| Survey Points | NW Corner XY Coord | X | Y | Surface XY | X | Y | m | | | |
|---------------|--------------------|--------|---|------------|---------|--------|------------------|-----------------|------------------|-----------------|
| | | | | | | | North Line slope | East Line slope | South Line slope | West Line slope |
| | 1717345 | 240595 | | | 1719279 | 238139 | -0.0104922 | 0.0155127 | -0.0093316 | 0.018875 |
| | 1717295 | 237946 | | | | | | | | |
| | 1722587 | 240540 | | | | | | | | |
| | 1722548 | 237897 | | | | | | | | |

| Measured Depth (ft) | Sub-Sea Incl. (deg) | Vertical Azim. (ft) | True Vert Depth (ft) | Northings (+) Southings (-) (ft) | Eastings (+) Westings (-) (ft) | Vert Section (ft) | DLS deg/100' (deg) | FNL | FSL | FWL | FEL | |
|------------------------|---------------------|---------------------|----------------------|----------------------------------|--------------------------------|-------------------|--------------------|-------|------|------|------|------|
| | | | | | | | | | | | | |
| 0 | 0.0 | 0 | 0 | 0 | 0 | 0 | 0 | 2436 | 212 | 1980 | 3271 | |
| 1162 | 1.30 | 214.10 | 1161.90 | -11 | -7 | -11.13 | 0.11 | 2447 | 201 | 1973 | 3278 | |
| 1633 | 1.10 | 163.40 | 1632.81 | -20 | -9 | -19.93 | 0.22 | 2456 | 192 | 1972 | 3280 | |
| 2109 | 0.90 | 141.10 | 2108.74 | -27 | -5 | -27.11 | 0.09 | 2463 | 185 | 1975 | 3276 | |
| 2584 | 1.10 | 118.20 | 2583.67 | -32 | 1 | -31.97 | 0.09 | 2468 | 180 | 1982 | 3269 | |
| 3059 | 0.90 | 131.60 | 3058.60 | -37 | 8 | -36.39 | 0.07 | 2472 | 175 | 1989 | 3262 | |
| 3534 | 0.60 | 16.50 | 3533.57 | -37 | 11 | -36.38 | 0.27 | 2472 | 175 | 1992 | 3259 | |
| 4008 | 0.40 | 150.30 | 4007.56 | -36 | 13 | -35.39 | 0.20 | 2471 | 176 | 1994 | 3257 | |
| 4090 | 0.50 | 190.10 | 4088.56 | -36 | 13 | -35.99 | 0.39 | 2472 | 175 | 1994 | 3257 | |
| 4135 | 0.10 | 3.90 | 4134.56 | -37 | 13 | -36.14 | 1.33 | 2472 | 175 | 1994 | 3257 | |
| 4167 | 2.10 | 9.60 | 4166.55 | -36 | 13 | -35.53 | 6.25 | 2472 | 176 | 1994 | 3257 | |
| 4199 | 4.20 | 9.40 | 4198.50 | -34 | 13 | -33.79 | 6.56 | 2470 | 177 | 1994 | 3257 | |
| 4231 | 6.10 | 9.00 | 4230.37 | -31 | 14 | -30.94 | 5.94 | 2467 | 180 | 1995 | 3257 | |
| 4262 | 8.00 | 8.50 | 4261.14 | -28 | 14 | -27.16 | 6.13 | 2463 | 184 | 1995 | 3256 | |
| 4294 | 9.80 | 10.50 | 4292.75 | -23 | 15 | -22.26 | 5.71 | 2458 | 189 | 1996 | 3255 | |
| 4326 | 11.80 | 9.30 | 4324.18 | -17 | 16 | -16.32 | 6.29 | 2452 | 195 | 1997 | 3254 | |
| 4357 | 14.00 | 9.00 | 4354.40 | -10 | 17 | -9.46 | 7.10 | 2446 | 202 | 1998 | 3253 | |
| 4389 | 16.70 | 7.30 | 4385.25 | -2 | 18 | -1.04 | 8.55 | 2437 | 210 | 1999 | 3252 | |
| 4421 | 18.70 | 5.10 | 4415.74 | 8 | 19 | 8.66 | 6.59 | 2427 | 220 | 2000 | 3251 | |
| 4452 | 20.00 | 3.90 | 4444.99 | 18 | 20 | 18.92 | 4.39 | 2417 | 230 | 2000 | 3251 | |
| 4484 | 21.10 | 3.80 | 4474.95 | 30 | 21 | 30.15 | 3.47 | 2406 | 241 | 2001 | 3250 | |
| 4516 | 23.10 | 4.30 | 4504.60 | 42 | 22 | 42.18 | 6.32 | 2394 | 253 | 2001 | 3250 | |
| 4547 | 25.90 | 3.80 | 4532.80 | 54 | 23 | 55.02 | 9.06 | 2381 | 266 | 2002 | 3249 | |
| 4579 | 29.00 | 3.10 | 4561.20 | 69 | 24 | 69.77 | 9.74 | 2366 | 281 | 2003 | 3248 | |
| 4611 | 32.30 | 2.80 | 4588.72 | 85 | 24 | 86.07 | 10.32 | 2350 | 297 | 2003 | 3248 | |
| 4642 | 35.20 | 1.90 | 4614.50 | 103 | 25 | 103.30 | 9.49 | 2333 | 314 | 2004 | 3247 | |
| 4674 | 37.30 | 0.80 | 4640.30 | 121 | 26 | 122.22 | 8.87 | 2314 | 333 | 2004 | 3247 | |
| 4706 | 38.50 | 0.90 | 4665.55 | 141 | 26 | 141.87 | 3.76 | 2294 | 353 | 2004 | 3247 | |
| 4737 | 40.30 | 1.30 | 4689.50 | 161 | 26 | 161.55 | 5.86 | 2275 | 373 | 2004 | 3247 | |
| 4769 | 41.80 | 1.10 | 4713.64 | 182 | 27 | 182.58 | 4.71 | 2254 | 394 | 2004 | 3247 | |
| 4801 | 44.10 | 1.00 | 4737.06 | 204 | 27 | 204.36 | 7.19 | 2232 | 415 | 2004 | 3247 | |
| 4832 | 46.20 | 0.80 | 4758.92 | 226 | 27 | 226.34 | 6.79 | 2210 | 437 | 2003 | 3247 | |
| 4864 | 48.10 | 0.00 | 4780.68 | 249 | 28 | 249.79 | 6.21 | 2186 | 461 | 2003 | 3247 | |
| Top of Tangent @ 4896' | 4896 | 49.00 | 359.90 | 4001.86 | 273 | 28 | 273.77 | 2.82 | 2162 | 485 | 2003 | 3247 |
| | 4927 | 48.50 | 359.40 | 4822.30 | 296 | 27 | 297.06 | 2.02 | 2139 | 508 | 2002 | 3248 |
| | 4959 | 48.20 | 359.30 | 4843.57 | 320 | 27 | 320.95 | 0.97 | 2115 | 532 | 2001 | 3249 |
| | 4991 | 47.80 | 359.30 | 4865.02 | 344 | 27 | 344.67 | 1.88 | 2091 | 556 | 2001 | 3249 |
| Blm of Tangent @ 5022' | 5022 | 47.40 | 358.80 | 4885.97 | 367 | 26 | 367.50 | 1.35 | 2069 | 579 | 2000 | 3250 |
| | 5054 | 48.50 | 358.80 | 4907.81 | 390 | 26 | 390.86 | 2.81 | 2045 | 602 | 1999 | 3251 |
| | | 45.90 | 359.30 | 4929.96 | 413 | 26 | 413.93 | 2.19 | 2022 | 625 | 1998 | 3252 |
| | | 47.20 | 0.40 | 4951.28 | 436 | 26 | 436.42 | 4.92 | 2000 | 648 | 1998 | 3252 |
| | 5149 | 49.40 | 1.30 | 4972.56 | 460 | 28 | 460.31 | 7.19 | 1976 | 671 | 1998 | 3252 |
| | 5181 | 52.70 | 2.60 | 4992.68 | 485 | 27 | 485.19 | 10.79 | 1951 | 696 | 1998 | 3252 |
| | 5212 | 56.30 | 3.10 | 5010.68 | 510 | 28 | 510.42 | 11.69 | 1926 | 722 | 1999 | 3251 |
| | 5244 | 60.00 | 3.80 | 5027.56 | 537 | 30 | 537.59 | 11.71 | 1898 | 749 | 2000 | 3249 |
| | 5276 | 64.20 | 3.50 | 5042.53 | 565 | 31 | 565.85 | 13.15 | 1870 | 777 | 2001 | 3248 |
| | 5307 | 68.40 | 3.30 | 5054.99 | 593 | 33 | 594.22 | 13.56 | 1842 | 805 | 2002 | 3247 |
| | 5339 | 72.50 | 3.40 | 5066.70 | 624 | 35 | 624.36 | 12.82 | 1812 | 835 | 2003 | 3246 |
| | 5371 | 77.20 | 3.50 | 5074.06 | 654 | 37 | 655.22 | 14.69 | 1781 | 866 | 2005 | 3244 |
| | 5403 | 81.40 | 3.00 | 5080.00 | 686 | 39 | 686.65 | 13.22 | 1750 | 898 | 2006 | 3243 |
| | 5434 | 85.70 | 2.90 | 5083.48 | 717 | 40 | 717.44 | 13.88 | 1719 | 928 | 2007 | 3242 |
| | 5450 | 88.30 | 2.80 | 5084.32 | 733 | 41 | 733.41 | 16.26 | 1703 | 944 | 2007 | 3241 |
| | 5561 | 92.40 | 3.00 | 5083.64 | 843 | 47 | 844.37 | 3.70 | 1592 | 1055 | 2011 | 3237 |
| | 5653 | 92.40 | 3.10 | 5079.78 | 935 | 51 | 936.26 | 0.11 | 1500 | 1147 | 2014 | 3234 |
| | 5745 | 92.10 | 2.10 | 5076.17 | 1027 | 56 | 1028.18 | 1.14 | 1408 | 1239 | 2017 | 3231 |
| | 5837 | 91.80 | 0.80 | 5073.04 | 1119 | 58 | 1120.12 | 1.45 | 1316 | 1331 | 2017 | 3230 |
| | 5930 | 91.50 | 0.80 | 5070.36 | 1212 | 59 | 1213.07 | 0.32 | 1223 | 1424 | 2017 | 3230 |
| | 6023 | 91.60 | 0.60 | 5067.85 | 1305 | 60 | 1306.03 | 0.24 | 1130 | 1517 | 2016 | 3231 |
| | 6116 | 91.70 | 0.60 | 5065.17 | 1398 | 61 | 1398.97 | 0.11 | 1037 | 1610 | 2015 | 3231 |
| | 6210 | 90.90 | 359.50 | 5063.04 | 1492 | 61 | 1492.90 | 1.45 | 943 | 1704 | 2014 | 3232 |
| | 6303 | 90.90 | 359.10 | 5061.58 | 1585 | 60 | 1585.81 | 0.43 | 850 | 1797 | 2011 | 3235 |
| | 6398 | 89.50 | 358.00 | 5061.25 | 1680 | 58 | 1680.66 | 1.88 | 755 | 1892 | 2007 | 3239 |
| | 6493 | 88.90 | 357.60 | 5062.57 | 1775 | 54 | 1775.43 | 0.76 | 661 | 1987 | 2001 | 3244 |
| | 6585 | 88.40 | 359.10 | 5064.74 | 1867 | 52 | 1867.24 | 1.72 | 569 | 2079 | 1997 | 3248 |
| | 6678 | 89.60 | 1.60 | 5066.36 | 1960 | 52 | 1960.19 | 2.98 | 476 | 2172 | 1996 | 3249 |

| Measured Depth (ft) | Sub-Sea Incl. (deg) | Vertical Azim. (ft) | True Vert Depth (ft) | Northings (+) Southings (-) (ft) | Eastings (+) Westings (-) (ft) | Vert Section (ft) | DLS deg/100' (deg) | | | | |
|---------------------------|---------------------------|---------------------------|----------------------------|--|--------------------------------------|-------------------------|--------------------------|-------|------|------|------|
| | | | | | | | | FNL | FSL | FWL | FEL |
| 6772 | 89.90 | 2.00 | 5066.77 | 2053 | 65 | 2054.19 | 0.53 | 382 | 2265 | 1997 | 3248 |
| 6865 | 89.90 | 2.10 | 5066.94 | 2146 | 58 | 2147.19 | 0.11 | 289 | 2358 | 1998 | 3246 |
| 6960 | 89.90 | 2.00 | 5067.10 | 2241 | 62 | 2242.19 | 0.11 | 194 | 2453 | 2000 | 3244 |
| 7056 | 89.50 | 1.40 | 5067.60 | 2337 | 65 | 2338.19 | 0.75 | 98 | 2549 | 2001 | 3242 |
| 7152 | 90.00 | 1.80 | 5068.02 | 2433 | 67 | 2434.19 | 0.67 | 2 | 2645 | 2002 | 3241 |
| 7247 | 90.60 | 2.30 | 5067.53 | 2528 | 71 | 2529.19 | 0.82 | -93 | 2740 | 2003 | 3239 |
| 7343 | 90.80 | 2.30 | 5066.35 | 2624 | 75 | 2625.18 | 0.21 | -169 | 2836 | 2005 | 3237 |
| 7438 | 90.90 | 2.10 | 5064.94 | 2719 | 78 | 2720.16 | 0.24 | -204 | 2931 | 2007 | 3235 |
| 7533 | 91.10 | 1.80 | 5063.29 | 2814 | 81 | 2815.15 | 0.38 | -379 | 3026 | 2009 | 3233 |
| 7627 | 90.20 | 1.80 | 5062.22 | 2908 | 84 | 2909.14 | 0.98 | -473 | 3120 | 2010 | 3232 |
| 7723 | 90.50 | 1.90 | 5061.63 | 3004 | 87 | 3005.14 | 0.44 | -589 | 3216 | 2011 | 3230 |
| 7818 | 90.70 | 1.60 | 5060.64 | 3099 | 90 | 3100.14 | 0.38 | -654 | 3311 | 2012 | 3229 |
| 7913 | 90.80 | 2.00 | 5059.39 | 3194 | 93 | 3195.13 | 0.43 | -759 | 3406 | 2013 | 3227 |
| 8008 | 91.60 | 1.90 | 5057.40 | 3289 | 96 | 3290.11 | 0.85 | -854 | 3501 | 2015 | 3225 |
| 8104 | 90.00 | 1.80 | 5056.08 | 3385 | 99 | 3386.10 | 1.67 | -950 | 3597 | 2016 | 3224 |
| 8199 | 89.70 | 0.80 | 5056.31 | 3480 | 102 | 3481.09 | 1.10 | -1045 | 3692 | 2016 | 3223 |
| 8294 | 88.50 | 359.40 | 5067.81 | 3575 | 102 | 3576.04 | 1.94 | -1140 | 3787 | 2015 | 3224 |
| 8389 | 90.90 | 0.00 | 5058.30 | 3670 | 101 | 3670.97 | 2.61 | -1235 | 3882 | 2012 | 3226 |
| 8485 | 91.10 | 0.00 | 5056.63 | 3766 | 101 | 3766.92 | 0.21 | -1331 | 3978 | 2011 | 3228 |
| 8580 | 89.70 | 0.30 | 5055.96 | 3861 | 102 | 3861.88 | 1.51 | -1426 | 4073 | 2009 | 3229 |
| 8675 | 87.20 | 0.50 | 5058.53 | 3956 | 102 | 3956.81 | 2.64 | -1521 | 4168 | 2008 | 3230 |
| 8770 | 88.80 | 0.90 | 5061.65 | 4050 | 103 | 4051.73 | 1.74 | -1616 | 4263 | 2007 | 3230 |
| 8865 | 90.90 | 3.00 | 5062.10 | 4145 | 107 | 4148.72 | 3.13 | -1711 | 4358 | 2009 | 3228 |
| 8960 | 88.50 | 2.30 | 5062.60 | 4240 | 111 | 4241.70 | 2.63 | -1806 | 4453 | 2011 | 3226 |
| 9055 | 89.80 | 3.00 | 5064.00 | 4335 | 115 | 4336.68 | 1.56 | -1901 | 4548 | 2014 | 3223 |
| 9150 | 89.80 | 3.90 | 5064.34 | 4430 | 121 | 4431.64 | 0.95 | -1996 | 4643 | 2018 | 3218 |
| 9203 | 89.60 | 3.90 | 5064.61 | 4483 | 125 | 4484.60 | 0.38 | -2048 | 4696 | 2020 | 3216 |
| 9254 | 89.60 | 3.90 | 5064.97 | 4534 | 128 | 4535.56 | 0.00 | -2099 | 4746 | 2023 | 3213 |

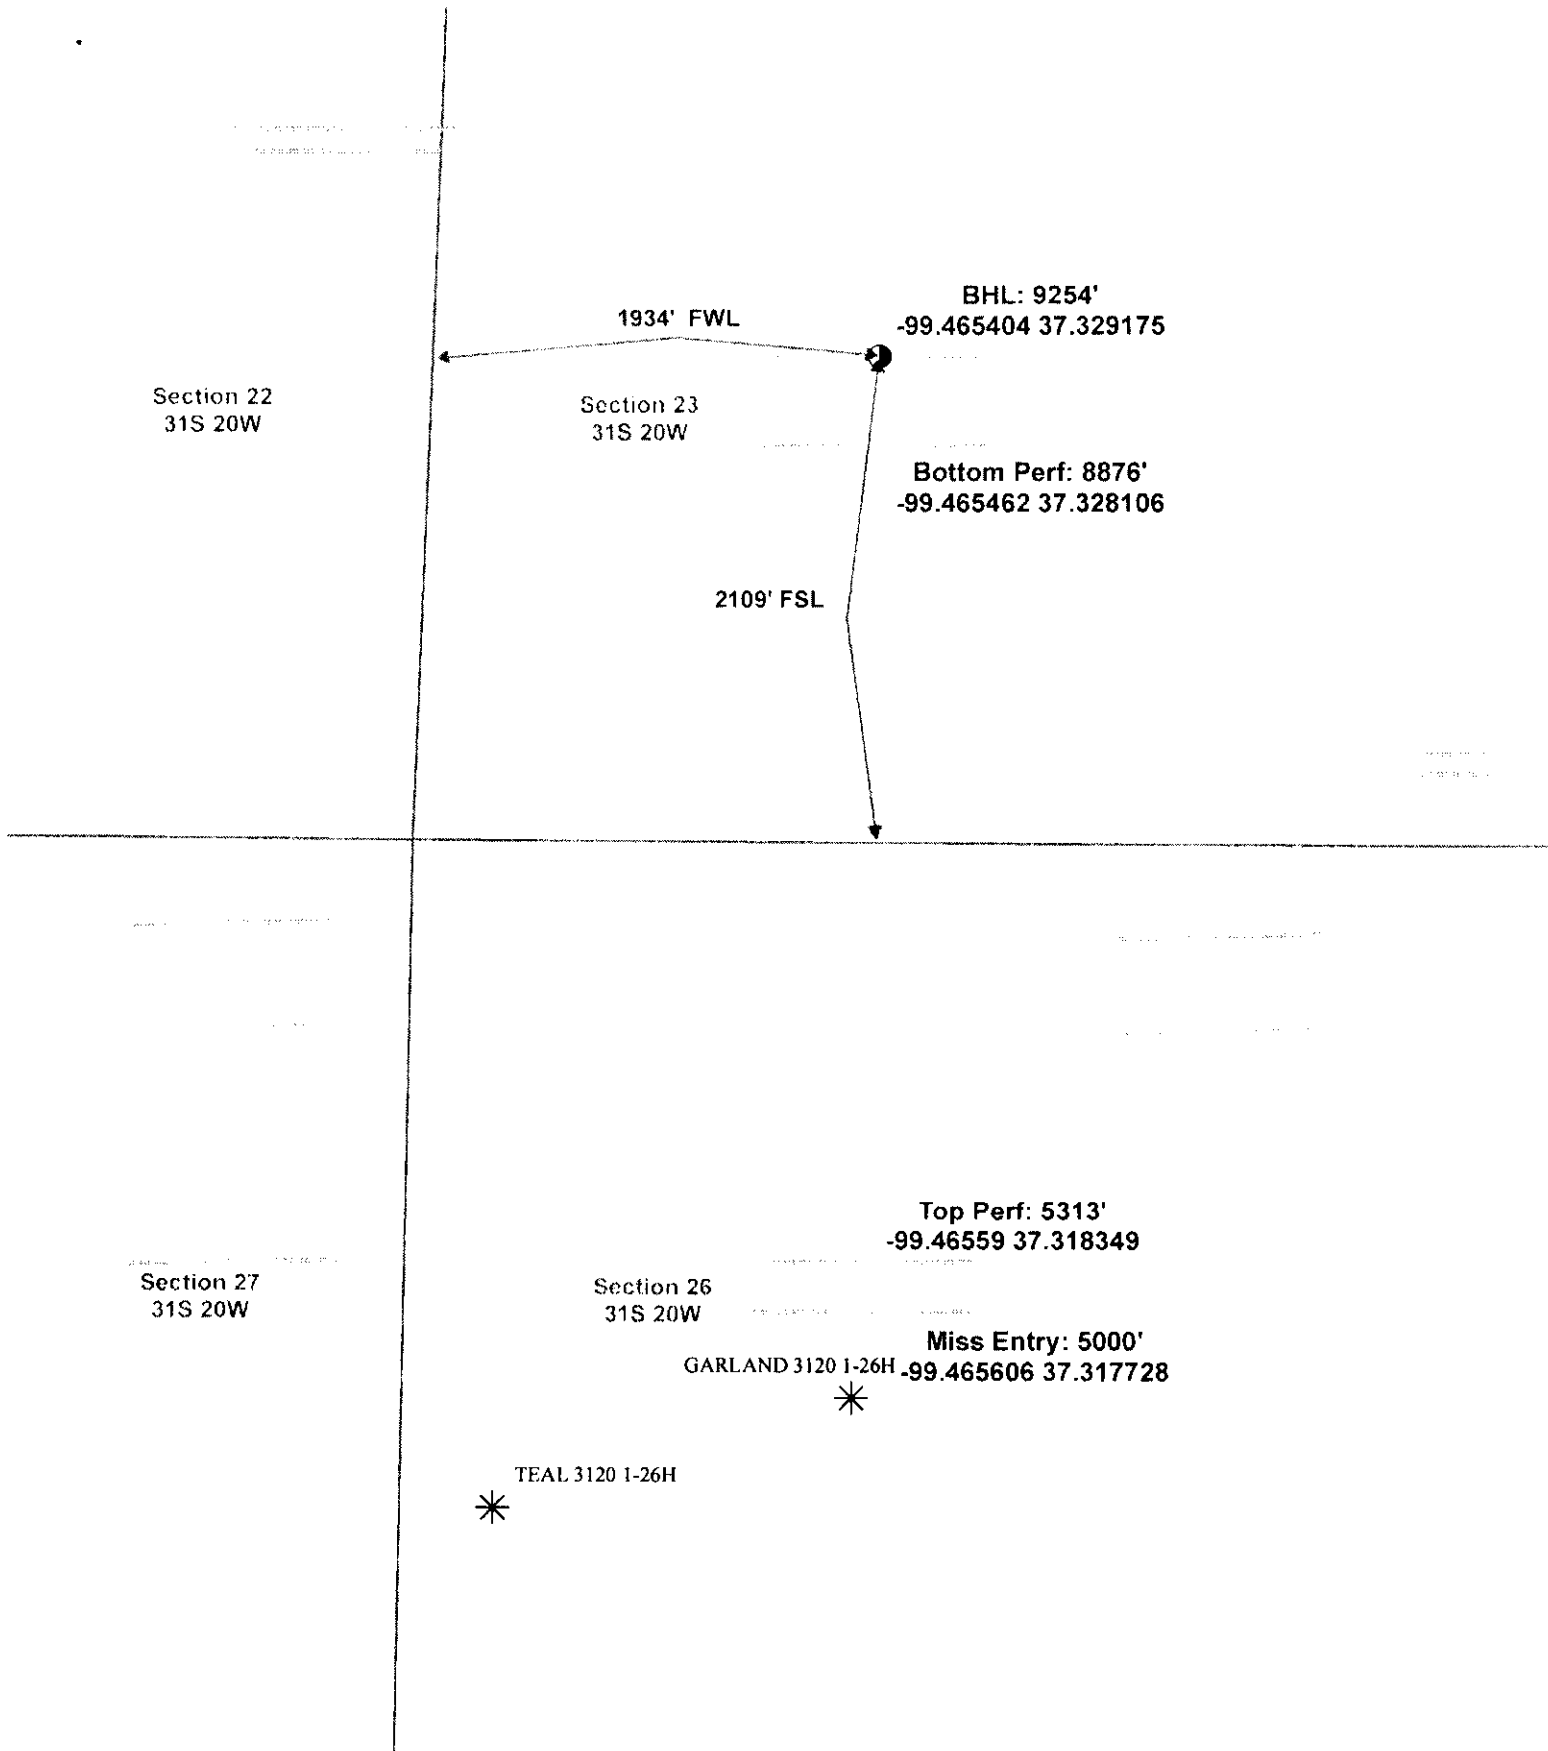

Section 22
31S 20W

Section 23
31S 20W

BHL: 9254'
-99.465404 37.329175

Bottom Perf: 8876'
-99.465462 37.328106

2109' FSL

Section 27
31S 20W

Section 26
31S 20W

Top Perf: 5313'
-99.46559 37.318349


Miss Entry: 5000'
GARLAND 3120 1-26H -99.465606 37.317728

TEAL 3120 1-26H



Actual Bottom-Hole Location of Garland 3120 1-26H
Comanche County, Kansas
T&R: 31S 20W
Section: 23, 1934' FWL & 2109' FSL
Long/Lat: -99.465404 37.329175

1 in = 833 ft

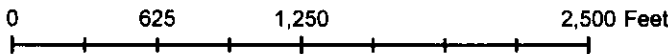

- Actual BH Location
- * SandRidge Wells
- Perf
- Sections

| | |
|---|------------------------|
| Draftsman: Aaron Birk | Draft Date: 12/19/2011 |
| Drawing Name/Number: Addendum_Garland_1-26H .mxd | |
| Coordinate System: NAD 1927 State Plane Kansas South FIPS: 1502 | |