

This form shall be filed in duplicate with the Kansas Corporation Commission, 200 Colorado Derby Building, Wichita, Kansas 67202, within ten days after the completion of the well, regardless of how the well was completed.

Attach separate letter of request if the information is to be held confidential. If confidential, only file one copy. Information on side one will be of public record and side two will then be held confidential.

Circle one: Oil, Gas, Dry, SWD, OWWO, Injection. Type and complete ALL sections. Applications must be filed for dual completion, commingling, SWD and injection, T.A.

Attach wireline logs (i.e. electrical log, sonic log, gamma ray neutron log, etc.). KCC # (316) 263-3238. (Rules 82-2-105 & 82-2-125)

OPERATOR PETRO-DYNAMICS, LTD. API NO. 15-051-22,661-0000

ADDRESS 555 N. WOODLAWN, BLDG. 1, SUITE 207 COUNTY ELLIS

WICHITA, KANSAS 67208 FIELD PARADISE

\*\*CONTACT PERSON KEN MORRISON PROD. FORMATION NONE

PHONE 316-681-1623 LEASE ALISON

PURCHASER WELL NO. #1

ADDRESS WELL LOCATION C NE SW


DRILLING KANDRILCO, LTD. 990' Ft. from WEST Line and

CONTRACTOR 990' Ft. from SOUTH Line of

ADDRESS 555 N. WOODLAWN, BLDG. 1, SUITE 207 the SW/4 SEC. 13 TWP. 11S RGE. 19W

WICHITA, KANSAS 67208

WELL PLAT

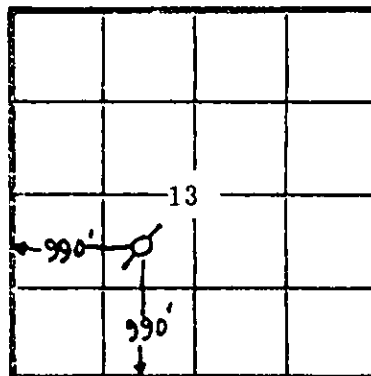

KCC  
KGS  
(Office Use)

PLUGGING CONTRACTOR ADDRESS

TOTAL DEPTH 3564' PBTD 3526'

SPUD DATE 11-6-81 DATE COMPLETED 11-17-81

ELEV: GR 1944' DF 1949' KB 1952'

DRILLED WITH (XX) (ROTARY) (XX) TOOLS

Amount of surface pipe set and cemented 246' DV Tool Used? NO

AFFIDAVIT

STATE OF KANSAS, COUNTY OF SEDGWICK SS, I,

JON R. STEWART OF LAWFUL AGE, BEING FIRST DULY SWORN UPON HIS OATH,

DEPOSES THAT HE IS A GEOLOGIST (FOR)(OF) PETRO-DYNAMICS, LTD.

OPERATOR OF THE ALISON LEASE, AND IS DULY AUTHORIZED TO MAKE

THIS AFFIDAVIT FOR AND ON THE BEHALF OF SAID OPERATOR, THAT WELL NO. #1

SAID LEASE HAS BEEN COMPLETED AS OF THE 18th DAY OF JANUARY, 1982, AND THAT


ALL INFORMATION ENTERED HEREIN WITH RESPECT TO SAID WELL IS TRUE AND CORRECT. JAN 25 1982

FURTHER AFFIANT SAITH NOT.

CONSERVATION DIVISION  
Wichita Kansas

(S) Jon R. Stewart  
JON R. STEWART

SUBSCRIBED AND SWORN BEFORE ME THIS 22nd DAY OF January, 1982.

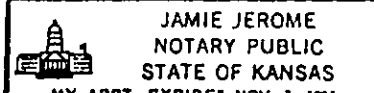

Jamie Jerome  
NOTARY PUBLIC

November 1, 1985

\*\*The person who can be reached by phone regarding any questions concerning this information. Within 45 days of completion, a witnessed initial test by the Commission is required if the well produces more than 25 BOPD or is located in a Basic Order Pool.