


STATE OF KANSAS
STATE CORPORATION COMMISSION
Give All Information Completely
Make Required Affidavit
Mail or Deliver Report to:
Conservation Division
State Corporation Commission
211 No. Broadway
Wichita, Kansas

WELL PLUGGING RECORD

NORTH

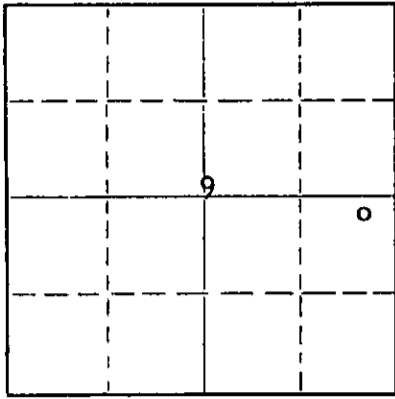

Locate well correctly on above Section Plat

Ellis County. Sec. 9 Twp. 11 Rge. 19W (E) (W)
Location as "NE/CNW/SE" or footage from lines NE NE SE
Lease Owner Okmar Oil Company
Lease Name Gustus Well No. 4
Office Address Union National Bldg - Wichita, Kansas
Character of Well (completed as Oil, Gas or Dry Hole) dry hole
Date well completed 11-16 19 56
Application for plugging filed 11-16 19 56
Application for plugging approved 11-16 19 56
Plugging commenced 11-16 19 56
Plugging completed 11-16 19 56
Reason for abandonment of well or producing formation dry

If a producing well is abandoned, date of last production 19
Was permission obtained from the Conservation Division or its agents before plugging was commenced? yes

Name of Conservation Agent who supervised plugging of this well Eldon Petty
Producing formation Depth to top Bottom Total Depth of Well 3600 Feet
Show depth and thickness of all water, oil and gas formations.

OIL, GAS OR WATER RECORDS

CASING RECORD

FORMATION	CONTENT	FROM	TO	SIZE	PUT IN	PULLED OUT
				8 5/8	205	none

Describe in detail the manner in which the well was plugged, indicating where the mud fluid was placed and the method or methods used in introducing it into the hole. If cement or other plugs were used, state the character of same and depth placed, from feet to feet for each plug set.

Plugged hole - set 1st plug @ 195 feet with 1/2 sack hulls.
Mixed & displaced 20 sx. thru drill pipe, 2nd plug @ 25' with 10 sx. cement.

12-20-56

(If additional description is necessary, use BACK of this sheet)

Name of Plugging Contractor Murfin Drilling Co.
Address 617 Union Center - Wichita, Kansas

STATE OF Kansas COUNTY OF Sedgwick, ss.
W. R. Murfin (employee of owner) or (owner or operator) of the above-described well, being first duly sworn on oath, says: That I have knowledge of the facts, statements, and matters herein contained and the log of the above-described well as filed and that the same are true and correct. So help me God.

(Signature) W R Murfin

SUBSCRIBED AND SWORN TO before me this 7th day of December, 19 56.

My commission expires 6-13-59. Betty Spriggs Notary Public.

PLUGGING
FILE SEC 9 T 11 R 19W
BOOK PAGE 119 L: E 24

WELL LOG


15051-03596-0000

COMPANY **Okmar Oil Company**
FARM **Gustus** NO. **4**

SEC. **9** T. **11** R. **19W**
LOC. **NE NE SE**

TOTAL DEPTH **3600**
COMM. **11-6-56** COMP. **11-16-56**
SHOT OR TREATED
CONTRACTOR **Murfin Drilling Co.**
ISSUED

COUNTY **Ellis**
KANSAS

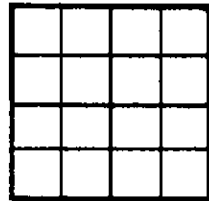

CASING
20 10
15 8 @ 205' w/150 sx.
12 6
13 5

ELEVATION **2041 DF**

PRODUCTION **D & A**

FIGURES INDICATE BOTTOM OF FORMATIONS

Tops:

620 Shells - Shale
790 Sand
850 Shale - Shells
1040 Sand
1375 Shale - Shells
1408 Anhydrite
1665 Red Bed - Shale
3245 Lime - Shale
3500 Lime
3565 Conglomerate
3585 Lime - Shale
3591 Lime
3595 Arbuckle
3600 Arbuckle lime

3600 RTD

Anhydrite 1405
Lansing 3269
Conglomerate 3500
Simpson 3564
Arbuckle 3584

DST #1 3430-65
Open 1 hr, Rec. 12' mud
BHP 0#

DST #2 3590-95
Open 1 hr, Rec. 33' mud
BHP 0#

State of Kansas
County of Sedgwick } SS:

I, W. R. Murfin of the Murfin Drilling Company

upon oath state that the above and foregoing is a true and correct copy of the log of the Gustus #4 well.

PLUGG.
FILE 9 11 19W
BOOK 119 PAGE 24

W. R. Murfin

Subscribed and sworn to before me this 7th day of December 1956.

My Commission Expires: 6-13-59

Betty Spragg
NOTARY PUBLIC