

STATE OF KANSAS
STATE CORPORATION COMMISSION

Give All Information Completely
Make Required Affidavit
Mail or Deliver Report to:
Conservation Division
State Corporation Commission
800 Biting Building
Wichita, Kansas

WELL PLUGGING RECORD

Ellis County. Sec. 9 Twp. 11 Rge. 19W (E) W (W)

Location as "NE/CNW/SW" or footage from lines NE NE SW

Lease Owner Okmar Oil Company

Lease Name Glinther "A"

Well No. 1

Office Address 817 Union National Bank Bldg. Wichita 2, Ks.

Character of Well (completed as Oil, Gas or Dry Hole) Dry Hole

Date well completed 7-30 1954

Application for plugging filed 7-30 1954

Application for plugging approved 7-30 1954


Plugging commenced 7-30 1954

Plugging completed 7-30 1954

Reason for abandonment of well or producing formation Too low structurally

If a producing well is abandoned, date of last production -- 19--

Was permission obtained from the Conservation Division or its agents before plugging was commenced? Yes

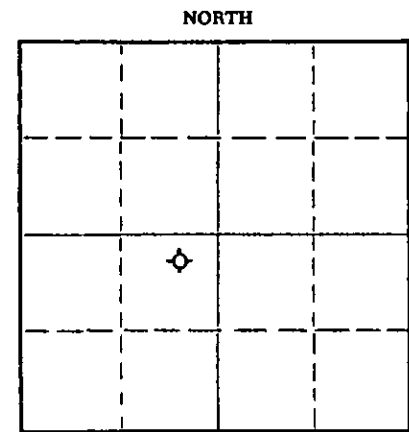

Locate well correctly on above Section Plat

Name of Conservation Agent who supervised plugging of this well Eldon Petty, Hays, Kansas

Producing formation -- Depth to top -- Bottom -- Total Depth of Well 3710 Feet

Show depth and thickness of all water, oil and gas formations.

OIL, GAS OR WATER RECORDS

CASING RECORD

FORMATION	CONTENT	FROM	TO	SIZE	PUT IN	PULLED OUT
				8-5/8"	191.91'	

Describe in detail the manner in which the well was plugged, indicating where the mud fluid was placed and the method or methods used in introducing it into the hole. If cement or other plugs were used, state the character of same and depth placed, from _____ feet to _____ feet for each plug set.

Filled hole with mud to 185'; set plug; 1/2 sack hulls, 15 sacks cement. Filled hole w/ mud to 40'; set plug then filled to top with 10 sacks cement, 1/2 sack hulls.

1954
DIVISION
08-04-54

Name of Plugging Contractor C-G DRILLING CO.
Address 107 Rule Building, Wichita, Kansas

STATE OF KANSAS, COUNTY OF SEDGWICK, ss.
Vicky Jacobs (employee of owner) or ~~XXXXXXXXXX~~ of the above-described well, being first duly sworn on oath, says: That I have knowledge of the facts, statements, and matters herein contained and the log of the above-described well as filed and that the same are true and correct. So help me God.

(Signature) Vicky Jacobs Office Manager
(Address)

SUBSCRIBED AND SWORN TO before me this 3rd day of August, 1954

Barbara Donaldson
Notary Public.

My commission expires June 17, 1957

PLUGGING
FILE SEC 9 T 11 R 19W
BOOK PAGE 33 LINE 3

CONTRACTOR'S WELL LOG

OPERATOR Okmar Oil Company FARM NAME Giinther "A" #1
 LOCATION NE NE SW, Sec. 9-11-19W
 POOL NAME _____ COUNTY Ellis STATE Kansas
 COMMENCEMENT DATE July 21, 1954 COMPLETION DATE July 30, 1954

LOG OF WELL

Elevation: 2109 R.B.
 All measurements from the top of rotary bushing.

FROM	TO	FORMATION	DEVIATION FROM VERTICAL	REMARKS:
0	190	Shale		
190	390	Shale		
390	1295	Anhydrite		
1295	1730	Red Bed-Shale	0° - 1500'	
1730	1995	Shale		
1995	2130	Shale-Shells	0° - 2000'	
2130	2375	Shale-Shells		
2375	2515	Shale-Shells	0° - 2500'	
2515	2735	Shale-Shells		
2735	2780	Lime-Shale		
2780	2885	Lime-Shale		
2885	3070	Shale-Sandy Shale	0° - 3000'	
3070	3185	Lime-Shale		
3185	3213	Lime-Shale		
3213	3279	Lime-Shale (Limey)		
3279	3345	Lime-Shale		
3345	3385	Lime-Shale		
3385	3425	Lime-Shale		DST 3385-3425'
3425	3440	Lime-Shale		
3440	3493	Lime-Shale		
3493	3539	Lime-Shale	0° - 3500'	
3539	3585	Lime		
3585	3652	Lime-Shale		
3652	3676	Lime-Limey Shale		
3676	3710	Lime		

CASING LEFT IN HOLE AFTER COMPLETION

Ran 191.91' (6 jts) of 8-5/8" Surface Casing.

STATE OF KANSAS, COUNTY OF SEDGWICK) ss.

The undersigned certifies that to the best of her knowledge and belief, the above facts are true and correct.

C-G DRILLING CO.

By Vicky Jacobs
 Office Manager

Subscribed and sworn to before me this 2nd day of August, 1954.

My commission expires: June 17, 1957

Barbara Donaldson
 Notary Public

PLUGGING
 FILE SEC 9-11-19W
 BOOK PAGE 53 LINE 3

NOTARY PUBLIC
 Wichita, Kansas