

STATE OF KANSAS
STATE CORPORATION COMMISSION

WELL PLUGGING RECORD

Give All Information Completely
Make Required Affidavit
Mail or Deliver Report to:
Conservation Division
State Corporation Commission
800 Bitting Building
Wichita, Kansas

Ellis County, Sec. 5 Twp 11S Rge. 19W (E) (W)

Location as "NE/CNW/SW" or footage from lines SE SE SE

Lease Owner Ben F. Brack Oil Company, Inc.

Lease Name Pulec Well No. 1

Office Address 309 Brown Bldg., Wichita, Kansas

Character of Well (completed as Oil, Gas or Dry Hole) Dry hole

Date well completed November 30 19 52

Application for plugging filed November 30 19 52

Application for plugging approved November 30 19 52

Plugging commenced 4:00 p.m., November 30 19 52


Plugging completed 11:30 p.m., November 30 19 52

Reason for abandonment of well or producing formation Commercial quantity of

oil not found

If a producing well is abandoned, date of last production _____ 19 _____

Was permission obtained from the Conservation Division or its agents before plugging was commenced? Yes

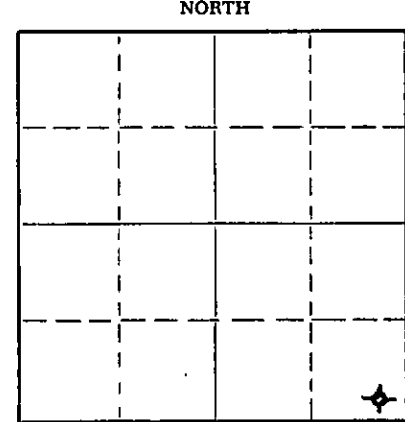

Locate well correctly on above Section Plat

Name of Conservation Agent who supervised plugging of this well Eldon Petty

Producing formation _____ Depth to top _____ Bottom _____ Total Depth of Well 3750 Feet

Show depth and thickness of all water, oil and gas formations.

OIL, GAS OR WATER RECORDS

CASING RECORD

FORMATION	CONTENT	FROM	TO	SIZE	PUT IN	PULLED OUT
				8 5/8"	241'	

Describe in detail the manner in which the well was plugged, indicating where the mud fluid was placed and the method or methods used in introducing it into the hole. If cement or other plugs were used, state the character of same and depth placed, from _____ feet to _____ feet for each plug set.

Set plug at 230' w/20 sacks cement. Filled with mud to 40'. Set another plug and 1/2 sack cotton seed hulls. Capped with 10 sacks cement.

RECEIVED
STATE CORPORATION COMMISSION
DEC 4 1952
CONSERVATION DIVISION
Wichita, Kansas

(If additional description is necessary, use BACK of this sheet)

Name of Plugging Contractor K & E DRILLING, INC.

Address 1006 Central Building, Wichita, Kansas

STATE OF Kansas, COUNTY OF Sedgwick, ss.

Clinton Engstrand, agent for _____ (employee of owner) or (owner or operator) of the above-described well, being first duly sworn on oath, says: That I have knowledge of the facts, statements, and matters herein contained and the log of the above-described well as filed and that the same are true and correct. So help me God.

(Signature) Clinton Engstrand
1006 Central Bldg., Wichita, Kansas
(Address)

SUBSCRIBED AND SWORN TO before me this 2 day of December, 1952

Stibbe J. J. J.
Notary Public.

My commission expires 10-29-55

PLUGGING
FILE SEC 5 T 11 R 1952
BOOK PAGE 63 LINE 11

BEN F. BRACK OIL COMPANY, INC.
No. 1 Pulec

SE SE SE Section 5-11S-19W
Ellis County, Kansas

Casing

8 5/8" Set @ 241'

Cement

135 Sacks

Conn: 11-17-52
Comp: 11-30-52
Total Depth: 3750

FORMATION

DEPTH

Surface soil	0 - 45
Shale and shells	45 - 620
Hard end shale	620 - 800
Shells and shale	800 - 910
Sand	910 - 1110
Red bed, shale and sand	1110 - 1430
Anhydrite	1430 - 1440
Anhydrite	1440 - 1475
Shale and shells	1475 - 1800
Salt, shale and shells	1800 - 1965
Shale and lime	1965 - 2150
Shale and lime	2150 - 2295
Lime and shale	2295 - 2830
Shale and shells	2830 - 2925
Lime and shale	2925 - 2950
Shale and lime	2950 - 3082
Lime	3082 - 3110
Lime and shale	3110 - 3175
Lime and shale	3175 - 3325
Lime	3325 - 3400
Lime and shale	3400 - 3585
Lime, shale and chert	3585 - 3649
Shale and lime	3649 - 3670
Lime	3670 - 3750

STATE OF KANSAS)
) SS
SEDGWICK COUNTY)

I hereby certify that the above information is true and correct to the best of my knowledge.

[Handwritten Signature]

Subscribed and sworn to before me this 3 day of December, 1952.

[Handwritten Signature]
Notary Public

My commission expires: 10-29-55

STATE CORPORATION
DEC - 4 1952
CONSERVATION DIVISION
Wichita, Kansas

PLUGGING
SEE SEC 5-11-192
BOOK PAGE 11