

STATE OF KANSAS  
STATE CORPORATION COMMISSION


Form CP-4

WELL PLUGGING RECORD

Give All Information Completely  
Make Required Affidavit  
Mail or Deliver Affidavit to:  
Conservation Division  
State Corporation Commission  
P. O. Box 17027  
Wichita, Kansas 67217  
NORTH

Logan County, Sec. 13 Twp. 11S Rge. XXX32W (W)

Location as "NE/CNW/SW" or footage from lines C NW SE  
Lease Owner Pickrell Drilling Company  
Lease Name Delzeit "A" Well No. 1  
Office Address 705 Fourth National Bank Bldg., Wichita, Kansas  
Character of Well (completed as Oil, Gas or Dry Hole) Dry Hole  
Date well completed January 12 19 73  
Application for plugging filed January 12 19 73  
Application for plugging approved January 12 19 73  
Plugging commenced January 12 19 73  
Plugging completed January 12 19 73  
Reason for abandonment of well or producing formation Dry Hole

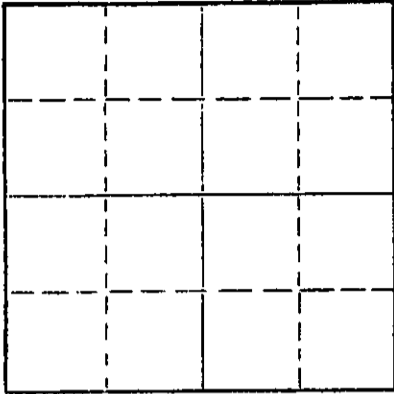

Locate well correctly on above Section Plat

If a producing well is abandoned, date of last production 19  
Was permission obtained from the Conservation Division or its agents before plugging was commenced? Yes

Name of Conservation Agent who supervised plugging of this well W. L. Nichols  
Producing formation \_\_\_\_\_ Depth to top \_\_\_\_\_ Bottom \_\_\_\_\_ Total Depth of Well 4686' Feet  
Show depth and thickness of all water, oil and gas formations.

OIL, GAS OR WATER RECORDS

CASING RECORD

FORMATION	CONTENT	FROM	TO	SIZE	PUT IN	PULLED OUT
				8-5/8"	251'	NONE

Describe in detail the manner in which the well was plugged, indicating where the mud fluid was placed and the method or methods used in introducing it into the hole. If cement or other plugs were used, state the character of same and depth placed, from \_\_\_\_\_ feet to \_\_\_\_\_ feet for each plug set.

Bottom Plug @ 1625' w/100 sacks, Middle Plug @ 280' w/30 sacks,  
Top Plug @ 40' w/10 sacks.

RECEIVED  
STATE CORPORATION COMMISSION  
JAN 18 1973  
CONSERVATION DIVISION  
Wichita, Kansas

(If additional description is necessary, use BACK of this sheet)  
Name of Plugging Contractor Pickrell Drilling Company  
Address 705 Fourth National Bank Building, Wichita, Kansas 67202

STATE OF Kansas, COUNTY OF Sedgwick, ss.  
C. W. Sebitts (employee or operator) of the above-described

well, being first duly sworn on oath, says: That I have knowledge of the facts, statements, and matters herein contained and the log of the above-described well as filed and that the same are true and correct. So help me God.

(Signature) C. W. Sebitts  
705 Fourth National Bank Bldg., Wichita, Kansas  
(Address)

Subscribed and sworn to before me this 16th day of January, 1973  
January 19, 1977



Esther Lamore  
Notary Public.

ROTARY DRILLING LOG

COMPANY: Pickrell Drilling Company  
705 Fourth National Bank Building  
Wichita, Kansas 67202  
LOCATION: Delzeit "A" No. 1, C NW SE Sec. 13-11S-32W,  
Logan County, Kansas

Rotary Drilling Commenced 12/27/72

Rotary Drilling Completed 1/12/73

CONTRACTOR: **PICKRELL DRILLING COMPANY**  
Wichita, Kansas

CASING RECORD: Ran 6 Jts. 8-5/8" surface casing set @ 251' K.B. Cemented with  
150 sacks. Completed 2:15 P.M. Circulated.  
No oil string run. D & A. Plugged down 1:45 P.M. January 12, 1973.

LOG

(Figures indicate bottom of formation — measurements from top of rotary bushing.)

45	Top Soil			
80	Sand			
2560	Shale	<u>C.F.S.</u>		
2690	Shale & Lime Stringers	3690	4195	4610
2820	Shale & Lime	3985	4221	4635
2990	Lime	3995	4250	4670
3645	Shale & Lime	4012	4285	4686
3720	Lime	4042	4330	
3965	Shale & Lime	4060	4471	
4042	Lime	4078	4505	
4078	Lime & Shale	4160	4520	
4385	Lime	4170	4570	
4487	Lime & Shale			
4686	Lime, RTD			

Slope Tests

- 2000
- 2500
- 3000
- 3500
- 4000
- 4500

**RECEIVED**  
STATE CORPORATION COMMISSION  
JAN 18 1973  
CONSERVATION DIVISION  
Wichita, Kansas

The undersigned, C. W. Sebitts, Attorney-in-Fact for PICKRELL DRILLING COMPANY, hereby certifies in behalf of said Company, that the above is a true and correct log of the formation encountered in drilling the above well as reflected by the Daily Drilling Reports.

PICKRELL DRILLING COMPANY

By C. W. Sebitts Attorney-in-Fact

STATE OF KANSAS }  
COUNTY OF SEDGWICK } ss.:

On this 16th day of January, 19 73, before me the undersigned, a Notary Public, in and for the County and State aforesaid, personally appeared C. W. Sebitts, to me known to be the identical person who subscribed the name of PICKRELL DRILLING COMPANY to the foregoing instrument as its Attorney-in-Fact and acknowledged to me that he executed the same as his free and voluntary act and deed, and as the free and voluntary act and deed of such company, for the uses and purposes therein set forth.

Given under my hand and seal of office the day and year last above written.

My commission expires: January 19, 1977

Esther Lamone  
Esther Lamone Notary Public

