

STATE OF KANSAS
STATE CORPORATION COMMISSION

Form CP-4


Give All Information Completely
Make Required Affidavit
Mail or Deliver Report to:
Conservation Division
State Corporation Commission
212 No. Market
Wichita, Kansas

WELL PLUGGING RECORD

Logan County. Sec. 13 Twp. 11S Rge. (E) 32 (W)

Location as "NE/CNWSW" or footage from lines SE SE
Lease Owner KWB Oil Property Management, Inc.
Lease Name Delzeit Well No. 1
Office Address 1125 NBT Bldg. Tulsa, Okla.
Character of Well (completed as Oil, Gas or Dry Hole) dry hole
Date well completed December 4 1969
Application for plugging filed December 4 1969
Application for plugging approved December 4 1969
Plugging commenced December 4 1969
Plugging completed December 4 1969
Reason for abandonment of well or producing formation dry hole

NORTH

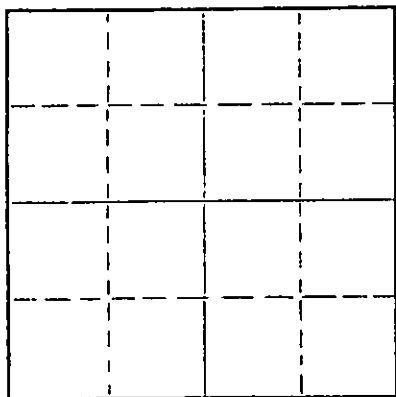

Locate well correctly on above
Section Plat

If a producing well is abandoned, date of last production 19
Was permission obtained from the Conservation Division or its agents before plugging was commenced? yes

Name of Conservation Agent who supervised plugging of this well W. L. Nichols
Producing formation Depth to top Bottom Total Depth of Well 4720 Feet
Show depth and thickness of all water, oil and gas formations.

OIL, GAS OR WATER RECORDS

CASING RECORD

FORMATION	CONTENT	FROM	TO	SIZE	PUT IN	PULLED OUT
				8 5/8"	287'	none

Describe in detail the manner in which the well was plugged, indicating where the mud fluid was placed and the method or methods used in introducing it into the hole. If cement or other plugs were used, state the character of same and depth placed, from feet to feet for each plug set.

Filled with mud to 1575' set plug with 100 sacks cement. Filled with mud to 40' plug and 10 sacks cement.

RECEIVED
STATE CORPORATION COMMISSION
JAN 16 1970
CONSERVATION DIVISION
Wichita, Kansas

(If additional description is necessary, use BACK of this sheet)
Name of Plugging Contractor Leben Drilling, Inc.
Address P.O. Box 486 Great Bend, Kansas


STATE OF KANSAS, COUNTY OF BARTON, ss.
James R. Rodgers (employee of owner) or (owner or operator) of the above-described well, being first duly sworn on oath, says: That I have knowledge of the facts, statements, and matters herein contained and the log of the above-described well as filed and that the same are true and correct. So help me God.

(Signature) James R. Rodgers
James R. Rodgers
P.O. Box 486 Great Bend, Kansas
(Address)

Subscribed and Sworn to before me this 14th day of January, 1970

Helen L. Lindenmuth
Helen L. Lindenmuth Notary Public.

My commission expires November 13, 1973

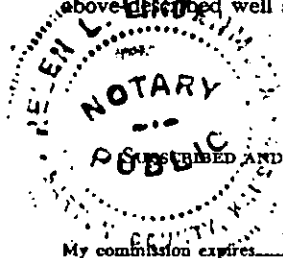

DRILLER'S LOG

COMPANY: KWB Oil Property Management, Inc.
 CONTRACTOR: LEBEN DRILLING, INC.
 FARM: DELZEIT #1
 LOCATION: SE SE SECTION 13-11S-32W
 LOGAN COUNTY, KANSAS
 COMMENCED: 11-23-69
 COMPLETED: 12-4-69

0	160	Clay Sand
160	305	Shale
305	2508	Shale & Shells
2508	2538	Anhydrite
2538	2743	Red Bed
2743	2937	Red Bed & Shale
2937	3453	Lime & Shale
3453	3549	Lime
3549	4021	Lime & Shale
4021	4720	Lime
	<u>4720</u>	<u>RTD D & A</u>

RECEIVED
 STATE CORPORATION COMMISSION
 JAN 16 1970
 CONSERVATION DIVISION
 Wichita, Kansas

8 5/8" New 20# Surface Casing set @ 287' cemented with 260 sacks Common Cement with 3% C.C.

I, James R. Rodgers, do hereby certify that the above and foregoing is a true and correct copy of the log of the Delzeit #1 Well, located SE SE of Section 13, Township 11 South, Range 32 West, Logan County, Kansas, as reflected by the records of Leben Drilling, Inc.

James R. Rodgers
 James R. Rodgers

STATE OF KANSAS)
) SS
 COUNTY OF BARTON)

Subscribed and sworn to and before me, a Notary Public, in and for Barton County, Kansas, this 14th day of January, 1970.

Helen L. Lindenmuth
 Helen L. Lindenmuth

My Commission Expires:
 November 13, 1973