


STATE OF KANSAS  
STATE CORPORATION COMMISSION

Form CP-4

WELL PLUGGING RECORD

Give All Information Completely  
Make Required Affidavit  
Mail or Deliver Report to:  
Conservation Division  
State Corporation Commission  
211 No. Broadway  
Wichita, Kansas

NORTH

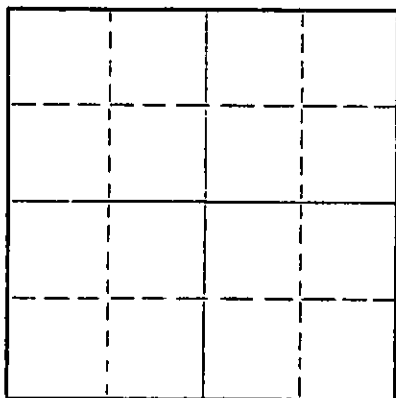

Locate well correctly on above  
Section Plat

Location as "NE/CNW/SE/SW" or footage from lines 6 Ellis County. Sec. 16 Twp. 11S Rge. 19W (S) (W)  
SW NW NW  
Lease Owner Oscar L. Stutenroth  
Lease Name Keller Well No. 2  
Office Address Peoples' State Bank Bldg., Ellinwood, Kansas  
Character of Well (completed as Oil, Gas or Dry Hole) Dry Hole  
Date well completed 1-23-66 19  
Application for plugging filed 1-23-66 19  
Application for plugging approved 1-23-66 19  
Plugging commenced 1-23-66 19  
Plugging completed 1-23-66 19  
Reason for abandonment of well or producing formation Dry Hole

If a producing well is abandoned, date of last production \_\_\_\_\_ 19\_\_\_\_  
Was permission obtained from the Conservation Division or its agents before plugging was commenced? yes

Name of Conservation Agent who supervised plugging of this well Gilbert Leiker, Victoria, Kansas  
Producing formation \_\_\_\_\_ Depth to top \_\_\_\_\_ Bottom \_\_\_\_\_ Total Depth of Well 3600 Feet  
Show depth and thickness of all water, oil and gas formations.

OIL, GAS OR WATER RECORDS

CASING RECORD

FORMATION	CONTENT	FROM	TO	SIZE	PUT IN	PULLED OUT
				8 5/8"	188'	none

Describe in detail the manner in which the well was plugged, indicating where the mud fluid was placed and the method or methods used in introducing it into the hole. If cement or other plugs were used, state the character of same and depth placed, from \_\_\_\_\_ feet to \_\_\_\_\_ feet for each plug set.

Set Plug @ 540' with 20 sacks cement  
Set Plug @ 180' with 20 sacks cement  
Bridged Plug @ 40' with 1/2 sack hulls and 10 sacks cement

JAN 27 1966  
CONSERVATION DIVISION  
WICHITA, KANSAS

(If additional description is necessary, use BACK of this sheet)

Name of Plugging Contractor Leben Drilling, Inc.  
Address Box 486, Great Bend, Kansas 67530

STATE OF KANSAS, COUNTY OF BARTON, ss.

Leslie Kite (employee of owner) or (owner or operator) of the above-described well, being first duly sworn on oath, says: That I have knowledge of the facts, statements, and matters herein contained and the log of the above-described well as filed and that the same are true and correct. So help me God.

(Signature) Leslie Kite  
Box 486, Great Bend, Kansas 67530  
(Address)

SUBSCRIBED AND SWORN TO before me this 26th day of January, 1966

My commission expires April 1, 1967

Ulonda Nichols  
Ulonda Nichols Notary Public.

DRILLER'S LOG

COMPANY: Oscar L. Stutenroth  
 CONTRACTOR: LEBEN DRILLING, INC.  
 FARM: KELLER #2 6  
 LOCATION: SW NW NW Sec. 16-11S-19W  
 ELLIS COUNTY, KANSAS  
 COMMENCED: 1-17-66  
 COMPLETED: 1-23-66

0	188	Clay, Sand, Shale
188	985	Shale, Shells
985	1195	Sand
1195	1250	Redbed
1250	1512	Redbed with Sand
1512	1561	Anhydrite
1561	1830	Shale, Shells
1830	3050	Lime, Shale
3050	3175	Shale, Lime
3175	3600	Lime
	<u>3600</u>	<u>RTD - D. &amp; A.</u>

STATE OF KANSAS  
 JAN 27 1966  
 CONSERVATION

Set 8 5/8" used surface casing @ 188' with 145 sacks Common 2% cc

I, Leslie Kite, do hereby certify that the above and foregoing is a true and correct copy of the log of the Keller #2 well, located SW NW NW of Section 16, Township 11 South, Range 19 West, Ellis County, Kansas, as reflected by the records of Leben Drilling, Inc.

*Leslie Kite*  
 Leslie Kite

STATE OF KANSAS )  
 ) SS  
 COUNTY OF BARTON)

Subscribed and sworn to and before me, a Notary Public, in and for Barton County, Kansas, this 26th day of January, 1966.

*Ulanda Nichols*  
 Ulanda Nichols

My Commission Expires:  
 April 1, 1967