

STATE OF KANSAS
STATE CORPORATION COMMISSION

Form CP-4

Give All Information Completely
Make Required Affidavit
Mail or Deliver Report to:
Conservation Division
State Corporation Commission
212 No. Market
Wichita, Kansas

WELL PLUGGING RECORD

Ellis

County. Sec. 6 Twp. 11S Rge. (X) 19 (W)

Location as "NE/CNW/SE" or footage from line App. Ctr. SE SW SE

Lease Owner Three G Oil, Inc.

Lease Name Armbrister Well No. 2

Office Address 1101 Wichita Plaza Bldg., Wichita, Kansas

Character of Well (completed as Oil, Gas or Dry Hole) Dry Hole

Date well completed September 26 19 67

Application for plugging filed Verbal Approval 19

Application for plugging approved Verbal Approval 19


Plugging commenced September 26 19 67

Plugging completed September 26 19 67

Reason for abandonment of well or producing formation _____

If a producing well is abandoned, date of last production _____ 19

Was permission obtained from the Conservation Division or its agents before plugging was commenced? Yes

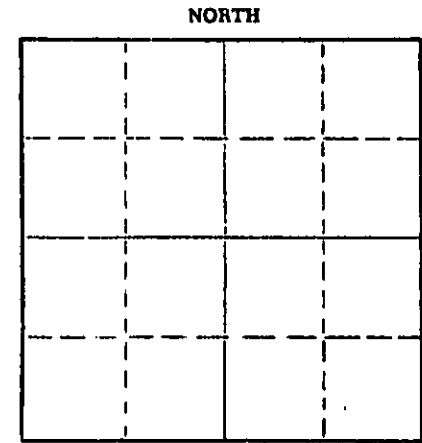

Locate well correctly on above Section Plat

Name of Conservation Agent who supervised plugging of this well Leo F. Massey

Producing formation _____ Depth to top _____ Bottom _____ Total Depth of Well 3724 Feet

Show depth and thickness of all water, oil and gas formations.

OIL, GAS OR WATER RECORDS

CASING RECORD

| FORMATION | CONTENT | FROM | TO | SIZE | PUT IN | PULLED OUT |
|-----------|---------|------|----|---------|--------|------------|
| | | | | 10-3/4" | 207' | None |
| | | | | | | |
| | | | | | | |
| | | | | | | |
| | | | | | | |
| | | | | | | |
| | | | | | | |
| | | | | | | |
| | | | | | | |

Describe in detail the manner in which the well was plugged, indicating where the mud fluid was placed and the method or methods used in introducing it into the hole. If cement or other plugs were used, state the character of same and depth placed, from _____ feet to _____ feet for each plug set.

Filled hole with heavy rotary mud from 3,724 feet (rotary total depth) to 800 feet. Set bottom plug at 800 feet and cemented by pump truck with 100 sacks cement. Filled hole with heavy rotary mud to 210 feet. Set plug at 210 feet and cemented with 25 sacks cement. Filled hole with heavy rotary mud to 40 feet. Set plug at 40 feet and cemented with 10 sacks cement, 2 sacks cement in rat hole.

SEP 29 1967

Name of Plugging Contractor H-30, Inc. (If additional description is necessary, use BACK of this sheet)
Address 200 North Main, Wichita, Kansas 67202

STATE OF KANSAS, COUNTY OF SEDGWICK, ss.

Arlo B. Romer (employee of owner) or (owner or operator) of the above-described well, being first duly sworn on oath, says: That I have knowledge of the facts, statements, and matters herein contained and the log of the above-described well as filed and that the same are true and correct. So help me God.

(Signature) Arlo B. Romer
200 North Main, Wichita, Kansas 67202
(Address)

SUBSCRIBED AND SWORN to before me this 29th day of September, 1967

Martha Hartpence
Martha Hartpence Notary Public.

My commission expires April 21, 1971

KANSAS GEOLOGICAL SOCIETY
KANSAS WELL LOG BUREAU - KANSAS WELL SAMPLE BUREAU
KANSAS GEOLOGICAL SOCIETY BUILDING
508 EAST MURDOCK - WICHITA, KANSAS

COMPANY Three G Oil, Inc.


SEC. 6 T. 11S. R. 19W
Loc. App. Ctr. SE SW SE

FARM Armbrister NO. 2

COUNTY Ellis

TOTAL DEPTH 3,724'
COMM. September 18, 1967 COMP. September 26, 1967

SHOT OR TREATED
CONTRACTOR H-30, Inc.
ISSUED

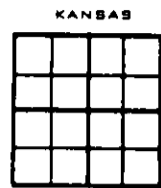

CASING

| | | | |
|----|---------|-------------------------------------|-------------------|
| 20 | 10-3/4" | 207' cemented with 150 sacks cement | ELEVATION 2143 KB |
| 15 | 8 | | |
| 12 | 6 | | |
| 13 | 5 | | |

FIGURES INDICATE BOTTOM OF FORMATIONS

ELECTRIC LOG TOPS

| | | | |
|---------------------|------|----------------|-------------|
| Surface Soil & Rock | 40 | | |
| Shale | 207 | Anhydrite | 1520 + 623 |
| Shale & Shell | 640 | Base Anhydrite | 1556 + 587 |
| Shale | 930 | Topeka | 3151 - 1008 |
| Sand | 1110 | Queen Hill | 3300 - 1157 |
| Shale | 1516 | Heebner | 3367 - 1224 |
| Anhydrite | 1561 | Toronto | 3392 - 1249 |
| Shale & Shells | 1915 | Lansing | 3408 - 1265 |
| Shale & Lime | 2150 | Base K.C. | 3629 - 1486 |
| Lime & Shale | 2700 | Conglomerate | 3687 - 1544 |
| Shale & Lime | 3055 | Simpson | 3703 - 1560 |
| Lime & Shale | 3170 | Log T. D. | 3724 - 1581 |
| Lime | 3724 | Rotary T. D. | 3724 - 1581 |
| Rotary Total Depth | 3724 | | |

I hereby certify the above and foregoing to be a true and correct log of the above described well as shown by the drilling reports.

H-30, INC.

Arlo B. Romer
Arlo B. Romer

STATE OF KANSAS }
COUNTY OF SEDGWICK } ss

Subscribed and Sworn to before me a Notary Public in and for said county and state this 29th day of September, 1967.

Martha Hartpence
Martha Hartpence - Notary Public

My Commission Expires:

April 21, 1971

RECEIVED
CORPORATION COMMISSION

SEP 29 1967

CONSERVATION DIVISION
WICHITA, KANSAS