


STATE OF KANSAS
STATE CORPORATION COMMISSION

WELL PLUGGING RECORD

Give All Information Completely
Make Required Affidavit
Mail or Deliver Report to:
Conservation Division
State Corporation Commission
212 North Market, Insurance Bldg.
Wichita, Kansas

Barton County. Sec. 6 Twp. 11 Rge. 19 (E) W (W)
Location as "NE/CNW/SW" or footage from lines SE NW SE
Lease Owner Harms-Burt Drilling Company
Lease Name Armbrister Well No. 1
Office Address P.O. Box 184 Great Bend, Kansas
Character of Well (completed as Oil, Gas or Dry Hole) Dry hole
Date well completed September 18 19 60
Application for plugging filed September 18 19 60
Application for plugging approved September 18 (verbally) 19 60
Plugging commenced September 18 19 60
Plugging completed September 18 19 60
Reason for abandonment of well or producing formation _____

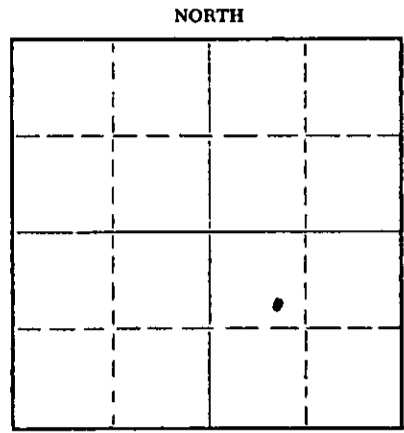

Locate well correctly on above Section Plat

If a producing well is abandoned, date of last production _____ 19 _____
Was permission obtained from the Conservation Division or its agents before plugging was commenced? Yes

Name of Conservation Agent who supervised plugging of this well Eldon Petty
Producing formation _____ Depth to top _____ Bottom _____ Total Depth of Well 3743 Feet
Show depth and thickness of all water, oil and gas formations.

OIL, GAS OR WATER RECORDS				CASING RECORD		
FORMATION	CONTENT	FROM	TO	SIZE	PUT IN	PULLED OUT
Surface		0	206'	8 5/8"	206'	none

Describe in detail the manner in which the well was plugged, indicating where the mud fluid was placed and the method or methods used in introducing it into the hole. If cement or other plugs were used, state the character of same and depth placed, from _____ feet to _____ feet for each plug set.

Filled hole with heavy mud from total depth to 660 feet with a plug and 20
sacks of cement at this point. Heavy mud to 180 feet with a plug and 15 sacks
of cement at this point. Heavy mud to 35 feet with a plug and 10 sacks of
cement at this point.

RECEIVED
OCT 11 1960
CONSERVATION DIVISION
WICHITA, KANSAS

(If additional description is necessary, use BACK of this sheet)
Name of Plugging Contractor Harms-Burt Drilling Company
Address P.O. Box 184 Great Bend, Kansas

STATE OF KANSAS, COUNTY OF BARTON, ss.
ALLAN HARMS (employee of owner) or (owner or operator) of the above-described well, being first duly sworn on oath, says: That I have knowledge of the facts, statements, and matters herein contained and the log of the above-described well as filed and that the same are true and correct. So help me God.

(Signature) Allan Harms
P.O. Box 184 Great Bend, Kansas
(Address)

SUBSCRIBED AND SWORN TO before me this 10 day of OCTOBER, 19 60

My commission expires 1-20-62

Mary E. Van Pelt
Notary Public.



DRILLERS LOG

Company: Harms-Burt Drilling Company
Farm: Armbrister # 1
Commenced: September 10, 1960

SE NW SE Section 12-11S-19W^b
Ellis County, Kansas
Completed: September 18, 1960

Elevation: 2141 KB

15.051.03061.0000

0 - 95	shale
95 - 175	Shale & pyrite
175 - 615	Shale
615 - 720	Sand
720 - 1285	Sand & shale
1285 - 1514	Red bed & shale
1514 - 1554	Anhydrite
1554 - 1785	Red bed & Shale
1785 - 2025	Shale & shells
2025 - 3241	Lime & shade
3241 - 3680	Lime
3680 - 3713	Lime - chert
3713 - 3743	Arbuckle
3743	Total depth

Set 206 feet of 8 5/8 inch surface pipe. Cemented with 150 sacks of common cement with 2% calcium chloride.

Tops:	Anhydrite	-	1514
	Topeka	-	3145
	Heebner	-	3362
	Toronto	-	3383
	Lansing - K. C.	-	3400
	Conglomerate	-	3675
	Arbuckle	-	3713

Drill Stem Tests: DST #1 3546' - 3637' Open 30 minutes. Shut in 30 minutes. Recovered 30 feet of mud. B. H. P. 1220 pounds.

Dry, plugged and abandoned.

AFFIDAVIT

RECORDED
STATE OF KANSAS
OCT 11 1960
CONSERVATION
WATER

STATE OF KANSAS)
)SS
COUNTY OF BARTON)

I, Allan Harms of the Harms-Burt Drilling Company being first duly sworn on oath state: I have knowledge of the facts, statements and matters herein contained and the same are true and correct.

Allan Harms

Subscribed and sworn to before me this 10 day of October, 1960.

My Comm. Expires
1-20-62

Mary E. Van Pelt
Notary Public