

STATE OF KANSAS  
STATE CORPORATION COMMISSION

Form CP-4


WELL PLUGGING RECORD

Give All Information Completely  
Make Required Affidavit  
Mail or Deliver Report to:  
Conservation Division  
State Corporation Commission  
212 No. Market  
Wichita, Kansas

Ellis County, Sec. 6 Twp. 11 Rge. 19 (E) W (W)

Location as "NE/CNW&SW&" or footage from lines SW SE NE  
Lease Owner Zenith Drilling Corporation, Inc.  
Lease Name Keller Well No. 1  
Office Address Wichita, Kansas --Garvey Bldg.  
Character of Well (completed as Oil, Gas or Dry Hole) Dry  
Date well completed 8-23-1966  
Application for plugging filed 8-23-1966  
Application for plugging approved 8-23-1966  
Plugging commenced 8-23-1966  
Plugging completed 8-23-1966  
Reason for abandonment of well or producing formation Dry

NORTH

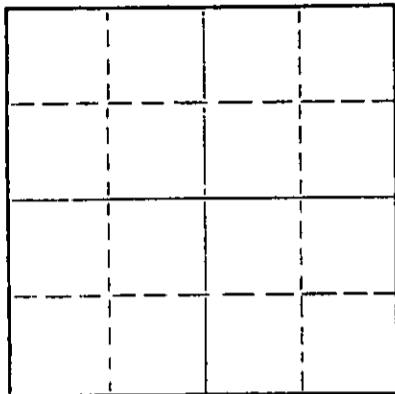

Locate well correctly on above Section Plat

If a producing well is abandoned, date of last production 19\_\_\_\_  
Was permission obtained from the Conservation Division or its agents before plugging was commenced? yes

Name of Conservation Agent who supervised plugging of this well Leo Massey-Hays, Kansas  
Producing formation \_\_\_\_\_ Depth to top \_\_\_\_\_ Bottom \_\_\_\_\_ Total Depth of Well 3725' Feet  
Show depth and thickness of all water, oil and gas formations.

OIL, GAS OR WATER RECORDS

CASING RECORD

FORMATION	CONTENT	FROM	TO	SIZE	PUT IN	PULLED OUT
SURFACE PIPE				8-5/8"	105'	

Describe in detail the manner in which the well was plugged, indicating where the mud fluid was placed and the method or methods used in introducing it into the hole. If cement or other plugs were used, state the character of same and depth placed, from \_\_\_\_\_ feet to \_\_\_\_\_ feet for each plug set.

Filled hole with rotary mud to a depth of 540' where 1st plug was set using 25 sacks cement. Filling hole with rotary mud to a depth of 100' where 2nd plug was set using 20 sacks cement. Rotary mud was used to fill hole to a depth of 40 where 3rd plug was set using 8 sacks cement and filling hole to surface.

RECEIVED  
STATE CORPORATION COMMISSION

AUG 25 1966

CONSERVATION DIVISION  
WICHITA, KANSAS

(If additional description is necessary, use BACK of this sheet)  
Name of Plugging Contractor L. J. Dreiling & Sons, Inc.  
Address Route # 2 Victoria, Kansas

STATE OF KANSAS, COUNTY OF ELLIS, ss.  
I, Leo F. Dreiling (employee of owner) or ~~owner or operator~~ of the above-described well, being first duly sworn on oath, says: That I have knowledge of the facts, statements, and matters herein contained and the log of the above-described well as filed and that the same are true and correct. So help me God.

(Signature) *Leo F. Dreiling*  
LEO F. DREILING

(Address)

SUBSCRIBED AND SWORN TO before me this 24th day of August, 1966

*Elmer Weitz*  
Elmer Weitz

Notary Public.

My commission expires October 26, 1968

L. J. DREILING and SONS, Inc.  
VICTORIA, KANSAS

WELL LOG

Company ZENITH DRILLING CORP., INC.  
Wichita, Kansas

Farm Keller No. # 1

Total Depth 3725'

Comm. 8-15-66 Comp. 8-23-66

Contractor L. J. Dreiling & Sons, Inc.  
Victoria, Kansas

Casing Record

Cement Record

Sec. 6 Twp. 11 Rng. 19

Location SW-SE-NE

County Ellis  
2104' K.B.

Elevation: 2101' D. F.

2099' G. R.

Production:

105' 8-5/8"

75 sax S.S.

D & A

Figures Indicate Bottom of Formations

0'	7'	Top Soil-Post Rock
7'	105'	Shale
105'	270'	Clay & Shale
270'	615'	Shale
615'	710'	Sand
710'	920'	Shale
920'	1150'	Sand
1150'	1400'	Shale
1400'	1476'	Red Bed & Shale
1476'	1516'	Anhy.
1516'	1776'	Shale & Shells
1776'	1990'	Shale & Shells
1990'	2142'	Shale & Strks Lime
2142'	2175'	Shale
2175'	2425'	Lime & Shale
2425'	2605'	Lime & Shale
2605'	2825'	Shale & Lime
2825'	2980'	Lime & Shale
2980'	3135'	Lime & Shale
3135'	3221'	Lime & Shale
3221'	3305'	Lime
3305'	3370'	Lime
3370'	3415'	Lime
3415'	3480'	Lime
3480'	3520'	Lime
3520'	3585'	Lime
3585'	3665'	Lime
3665'	3716'	Lime
3716'	3725'	Lime

RECEIVED  
STATE CORPORATION COMMISSION  
AUG 25 1966  
CONSERVATION DIVISION  
Wichita, Kansas

STATE OF KANSAS )  
                          )ss  
COUNTY OF ELLIS )

In Leo F. Dreiling, of the L. J. Dreiling & Sons, Inc. upon oath states that the above and foregoing is a true and correct copy from the Daily Drilling Report from your Keller # 1.

*Leo F. Dreiling*  
LEO F. DREILING

Subscribed and sworn to before me this 24th day of August , 1966.

*Eloise Weltz*  
NOTARY PUBLIC