


WELL PLUGGING RECORD

Give All Information Completely
Make Required Affidavit
Mail or Deliver Report to:
Conservation Division
State Corporation Commission
800 Biting Building
Wichita, Kansas

Ellis County. Sec. 35 Twp. 11 S Rge. 19 W (E) (W)

Location as "NE/CNWxSWx" or footage from lines NW NW NW
Lease Owner The Derby Oil Company
Lease Name Vine Well No. 1
Office Address 420 West Douglas, Wichita, Kansas
Character of Well (completed as Oil, Gas or Dry Hole) Dry Hole
Date well completed 7-24 19 53
Application for plugging filed 7-24 19 53
Application for plugging approved 7-24 19 53
Plugging commenced 7-24 19 53
Plugging completed 7-24 19 53
Reason for abandonment of well or producing formation

NORTH

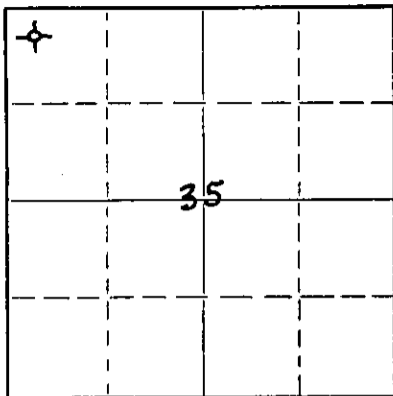

Locate well correctly on above Section Plat

If a producing well is abandoned, date of last production 19
Was permission obtained from the Conservation Division or its agents before plugging was commenced? yes

Name of Conservation Agent who supervised plugging of this well C. D. Stough
Producing formation Depth to top Bottom Total Depth of Well 3710 Feet
Show depth and thickness of all water, oil and gas formations.

OIL, GAS OR WATER RECORDS

CASING RECORD

FORMATION	CONTENT	FROM	TO	SIZE	PUT IN	PULLED OUT
SEE ATTACHED LOG						

Describe in detail the manner in which the well was plugged, indicating where the mud fluid was placed and the method or methods used in introducing it into the hole. If cement or other plugs were used, state the character of same and depth placed, from feet to feet for each plug set.

Filled hole with mud to 180', set plug and cemented with 15 sacks through drill pipe. Filled hole with mud to 40', set plug and 1/2 sack hulls, cemented with 10 sacks.

8-1-53

CONSERVATION

(If additional description is necessary, use BACK of this sheet)

Name of Plugging Contractor The Carl Todd Drilling Company
Address 404 KFH Building, Wichita, Kansas

STATE OF KANSAS, COUNTY OF SEDGWICK, ss.
F. W. Heiser (employee of owner) or (owner) of the above-described well, being first duly sworn on oath, says: That I have knowledge of the facts, statements, and matters herein contained and the log of the above-described well as filed and that the same are true and correct. So help me God.

(Signature) *F. W. Heiser*
Box 1030, Wichita, Kansas
(Address)

SUBSCRIBED AND SWORN TO before me this 31st day of July, 19 53

My commission expires August 24 1953

Notary Public.

PLUGGING
FILE SEC. 35 T. 11 S. R. 19 W
BOOK PAGE 118 LINE 21

THE GEARL TODD DRILLING COMPANY
604 KPM Building
Wichita, Kansas

THE DERRY OIL COMPANY
#1 Vias
NW NW NW Sec. 35-118-19W
Ellis County, Kansas

COMMENCED: July 14, 1953
COMPLETED: July 24, 1953

ELEVATION: 2123 NP

0 - 30	Surface rock & clay
30 - 204	Red stone, shale & shells
204 - 400	Shale and shells
400 - 915	Shale and shells
915 - 1140	Sand
1140 - 1250	Red bed, shells (iron strcs)
1250 - 1450	Red bed
1450 - 1485	Anhydrite
1485 - 1550	Shale
1550 - 1908	Shale and lime
1920 - 1985	Shale and salt
1985 - 2075	Shale and lime
2075 - 2250	Lime and shale
2250 - 2375	Shale and lime
2375 - 2460	Lime and shale
2460 - 2570	Lime and shale
2570 - 2605	Sand
2605 - 2645	Lime and shale
2645 - 2760	Lime and shale
2760 - 2870	Shale and lime
2870 - 3000	Shale and lime
3000 - 3056	lime and shale
3056 - 3140	Lime and shale
3140 - 3230	lime and shale
3230 - 3290	lime
3290 - 3338	lime
3338 - 3380	lime
3380 - 3432	lime
3430 - 3490	lime
3454 - 3482	lime
3482 - 3530	lime
3530 - 3575	lime
3575 - 3600	lime
3600 - 3698	lime
3698 - 3696	Shale and shale
3696 - 3700	Congl.
3700 - 3710	Anhydrite
3710	Rotary Seal Dep Oil

CASING RECORD

Set 8-5/8" OD casing at 204',
cemented with 125 sacks and
2 sacks CG

TOPS

Anhydrite	1450
Hoebner	3380
Larsing	3396
Conglomerate	3658
Arbuckle	3700

DST 3420 - 56, open 1 hour,
weak blow 3 min., recovered
15' mud, BHP 0'

RECEIVED
STATE CORPORATION COMMISSION
AUG - 1 1953
CONSERVATION DIVISION
Wichita, Kansas

I, Carl Todd, hereby certify that the above is a true and correct log to the best of my knowledge and belief.

THE GEARL TODD DRILLING COMPANY

Carl Todd

PLUGGING
FILE SEC 35-118-19W
BOOK PAGE 118-21