


15051-03517-0000

STATE OF KANSAS  
STATE CORPORATION COMMISSION

WELL PLUGGING RECORD

Give All Information Completely  
Make Required Affidavit  
Mail or Deliver Report to:  
Conservation Division  
State Corporation Commission  
800 Bittling Building  
Wichita, Kansas

Ellis County. Sec 35 Twp. 11S Rge. 19W (E) (W)  
Location as "NE/CNW/SW" or footage from lines NE NE SE  
Lease Owner J. F. Darby Oil Company  
Lease Name Steckline Well No. 1  
Office Address 1807 Philtower Bldg., Tulsa, Oklahoma  
Character of Well (completed as Oil, Gas or Dry Hole) Dry Hole  
Date well completed October 6 1957  
Application for plugging filed October 6 1957  
Application for plugging approved October 6 1957  
Plugging commenced October 6 1957  
Plugging completed October 6 1957  
Reason for abandonment of well or producing formation Too low structurally

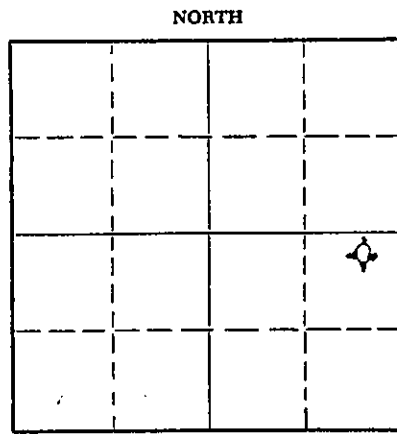

Locate well correctly on above  
Section Plat

If a producing well is abandoned, date of last production 19  
Was permission obtained from the Conservation Division or its agents before plugging was commenced? Yes

Name of Conservation Agent who supervised plugging of this well Eldon Petty, Hays, Kansas  
Producing formation \_\_\_\_\_ Depth to top \_\_\_\_\_ Bottom \_\_\_\_\_ Total Depth of Well 3659 Feet  
Show depth and thickness of all water, oil and gas formations.

OIL, GAS OR WATER RECORDS

CASING RECORD

FORMATION	CONTENT	FROM	TO	SIZE	PUT IN	PULLED OUT
				8-5/8"	180.09'	none

Describe in detail the manner in which the well was plugged, indicating where the mud fluid was placed and the method or methods used in introducing it into the hole. If cement or other plugs were used, state the character of same and depth placed, from \_\_\_\_\_ feet to \_\_\_\_\_ feet for each plug set.

Filled hole with heavy mud to 600'. Set plug. Put in 20 sacks cement. Filled to 170'. Set plug. Put in 1/2 sack hulls and 20 sacks cement. Filled with heavy mud up to 40'. Set plug. Filled to top with 1/2 sack hulls and 10 sacks cement.

10-11-57

(If additional description is necessary, use BACK of this sheet)

Name of Plugging Contractor C-G Drilling Co.  
Address 107 Rule Building, Wichita, Kansas

STATE OF KANSAS \_\_\_\_\_, COUNTY OF SEDGWICK, ss.  
G. F. Galloway (employee of owner) or (owner or operator) of the above-described well, being first duly sworn on oath, says: That I have knowledge of the facts, statements, and matters herein contained and the log of the above-described well as filed and that the same are true and correct. So help me God.

(Signature) G. F. Galloway  
107 Rule Bldg.  
(Address)

SUBSCRIBED AND SWORN TO before me this 10th day of October 1957

My commission expires 5/20/59  
Vicky Jacobs Notary Public.

24-7888-5 3-53-20M

PLUGGING  
FILE SEC 35 T. 11 R 19W  
BOOK PAGE 52 LINE 14

CONTRACTOR'S WELL LOG

OPERATOR J. F. Darby Oil Company WELL NAME Steckline #1  
 LOCATION NE NE SE SEC. 35-11S-19W RIG NO. 2  
 COUNTY Ellis STATE Kansas  
 COMMENCEMENT DATE September 27, 1957 COMPLETION DATE October 6, 1957

LOG OF WELL

Elevation 2080' rotary bushing.  
 All measurements taken from the top of rotary bushing.

FROM	TO	FORMATION	DEVIATION FROM VERTICAL	REMARKS:
0	180	Shale-Sand		
180	590	Shale-Shell		
590	745	Sand		
745	875	Sand-Shale		
875	1100	Sand		
1100	1415	Red Bed		
1415	1420	Red Bed		
1420	1452	Anhydrite		
1452	1770	Shale-Shell		
1770	2130	Shale-Shell		
2130	2275	Shale-Shell		
2275	2360	Shale-Lime		
2360	2450	Shale-Lime		
2450	2570	Shale-Lime	0° - 2500	
2570	2655	Shale-Lime		
2655	2795	Shale-Lime	0° - 2750	
2795	2967	Shale-Lime		
2967	3100	Shale-Lime	0° - 3000	
3100	3191	Shale-Lime		
3191	3242	Shale-Lime		
3242	3298	Lime	0° - 3250	
3298	3364	Lime		
3364	3414	Lime		
3414	3447	Lime		
3447	3515	Lime		
3515	3559	Lime		
3559	3597	Lime		
3597	3625	Lime		
3625	3643	Lime		DST 3638-3643'
3643	3648	Lime		DST 3643-3649'
3648	3649	Lime		
3649	3659	Lime		DST 3649-3659'

CASING LEFT IN HOLE AFTER COMPLETION

Ran 180.09' (9 jts.) 8-5/8" OD Surface casing.

STATE OF KANSAS }  
 COUNTY OF SEDGWICK } ss.

The undersigned hereby certifies that to the best of his knowledge and belief the above facts are true and correct.

C-G DRILLING CO.

By G. F. Galloway  
 G. F. Galloway

SUBSCRIBED AND SWORN TO BEFORE ME THIS 9th day of October, 1957.

Vicky Jacobs  
 Vicky Jacobs, Notary Public

My commission expires: May 20, 1959

PLUGGING  
 FILE SEC 35 T. 11 R 19W  
 BOOK PAGE 52 LINE 14