


STATE OF KANSAS
STATE CORPORATION COMMISSION

WELL PLUGGING RECORD

Give All Information Completely
Make Required Affidavit
Mail or Deliver Report to
Conservation Division
State Corporation Comm.
245 North Water
Wichita, KS 67202

Ness County. Sec. 30 Twp. 18S Rge. 25 E/W
Location as "NE/CNW 1/4 SW 1/4" or footage from lines
NW SE NE

Lease Owner Pickrell Drilling Company
Lease Name Tenny A Well No. 1
Office Address 205 Litwin Bldg., 110 N. Market, Wichita
Character of Well (Completed as Oil, Gas or Dry Hole) 67202
oil

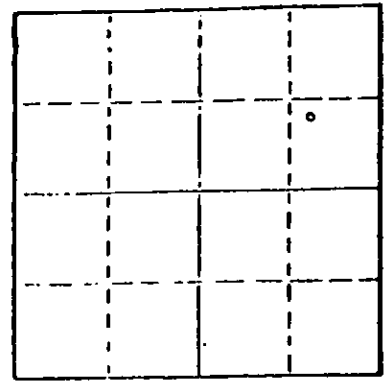

Date Well completed Nov. 12 1977
Application for plugging filed Dec. 1 1977
Application for plugging approved 19
Plugging commenced Dec. 3 1977
Plugging completed Dec. 23 1977

Reason for abandonment of well or producing formation
depleted
If a producing well is abandoned, date of last production
19

Was permission obtained from the Conservation Division or
its agents before plugging was commenced? yes

Name of Conservation Agent who supervised plugging of this well Leo F. Massey
Producing formation _____ Depth to top _____ Bottom _____ Total Depth of Well 4406'
Show depth and thickness of all water, oil and gas formations.

OIL, GAS OR WATER RECORDS

CASING RECORD

FORMATION	CONTENT	FROM	TO	SIZE	PUT IN	PULLED OUT
			206'	8 5/8"	206'	none
			4398'	5 1/2"	4398'	2627.93

Describe in detail the manner in which the well was plugged, indicating where the mud fluid
was placed and the method or methods used in introducing it into the hold. If cement or other
plugs were used, state the character of same and depth placed, from _____ feet to
_____ feet for each plug set.

Sanded back to 4375' and dumped 4 sacks of cement.

Allied Cementing Company, Inc. plugged well pumping in 1 sack of hulls,
30 sacks of gel and 120 sacks of cement.

RECEIVED
STATE CORPORATION COMMISSION

(If additional description is necessary, use BACK of this sheet)
Name of Plugging Contractor PIPE PULLERS, INC.
Box 128, Ellinwood, Kansas 67526 01-04-1978
CONSERVATION DIVISION
Wichita, Kansas

STATE OF KANSAS COUNTY OF BARTON, ss.
Evelyn Roth (employee of owner) or (~~owner or operator~~)
of the above-described well, being first duly sworn on oath, says: That I have knowledge of
the facts, statements, and matters herein contained and the log of the above-described well
as filed and that the same are true and correct. So help me God.

(Signature) Evelyn Roth
Ellinwood, Kansas
(Address)

SUBSCRIBED AND SWORN TO before me this 3 day of January, 1978

My commission expires _____

JENNY KASSELMAN
NOTARY PUBLIC
BARTON COUNTY, KANSAS
MY COMM. EXP. JULY 16, 1978

Jenny Kasselmann
Notary Public.

ROTARY DRILLING LOG

COMPANY: PICKRELL DRILLING COMPANY
205 LITWIN BLDG.
WICHITA, KS. 67202
LOCATION: Tenny "A" #1
NW SE NE Sec. 30-18S-25W
Ness Co., Ks.
CONTRACTOR: PICKRELL DRILLING COMPANY
Wichita, Kansas

Rotary Drilling Commenced 11-02-77
Rotary Drilling Completed 11-12-77

CASING RECORD:

Surface casing 8 5/8" set at 206' with 150sx. Comp. 7:20PM 11/2/77.
5 1/2" casing set at 4398' with 140sacks.

LOG

(Figures indicate bottom of formation — measurements from top of rotary bushing.)

Top Soil	40
Shale	210
Shale	790
Shale & Red Bed	1248
Sand	1454
Shale	1545
Shale	1745
Shale	1778
Shale	1988
Shale	2250
Shale & Lime	2405
Lime & Shale	2640
Lime & Shale	2780
Shale & Lime	2945
Lime	3110
Lime & Shale	3285
Shale & Lime	3351
Lime & Shale	3510
Shale & Lime	3730
Lime & Shale	3795
Lime	3950
Lime & Shale	4070
Lime & Shale	4160
Lime	4176
Shale & Lime	4230
Lime	4315
Lime	4324
Lime	4345
Lime	4399
Lime	4406

RECEIVED
STATE CORPORATION COMMISSION
DEC 02 1977
12-02-1977
CONSERVATION DIVISION
Wichita, Kansas

The undersigned, C. W. Sebitts, Attorney-in-Fact for PICKRELL DRILLING COMPANY, hereby certifies in behalf of said Company, that the above is a true and correct log of the formation encountered in drilling the above well as reflected by the Daily Drilling Reports.

PICKRELL DRILLING COMPANY
By [Signature]
Attorney-in-Fact
C. W. Sebitts

STATE OF KANSAS }
COUNTY OF SEDGWICK } ss.:

On this 1 day of December, 1977, before me the undersigned, a Notary Public, in and for

the County and State aforesaid, personally appeared C. W. Sebitts, to me known to be the identical person who subscribed the name of PICKRELL DRILLING COMPANY to the foregoing instrument as its Attorney-in-Fact and acknowledged to me that he executed the same as his free and voluntary act and deed, and as the free and voluntary act and deed of such company, for the uses and purposes therein set forth.

Given under my hand and seal of office the day and year last above written.
SHEILA A. BRANDA
STATE NOTARY PUBLIC
Sedgwick County, Kansas
My Appt. Exp. 6-21-81

Sheila A. Branda
Notary Public

My commission expires: June 21, 1981

Sheila A. Branda