


STATE OF KANSAS  
STATE CORPORATION COMMISSION

WELL PLUGGING RECORD

Give All Information Completely  
Make Required Affidavit  
Mail or Deliver Report to  
Conservation Division  
State Corporation Comm.  
245 North Water  
Wichita, KS 67202

Ness County, Sec. 35 Twp. 18S Rge. 25 E/W  
Location as "NE/CNW 1/4 SW 1/4" or footage from lines  
C NW NE (670' SNL & 1970' WEL of the NE/4)  
Lease Owner Theodore Leben & Assoc.  
Lease Name Humburg "A" Well No. 2  
Office Address 1555 E. 2nd Street, Wichita, Kansas 67214  
Character of Well (Completed as Oil, Gas or Dry Hole)  
Dry Hole

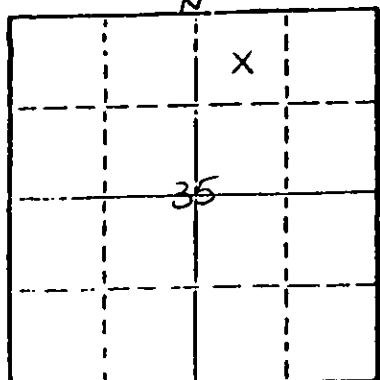

Locate well correctly on above  
Section Plot

Date Well completed September 10, 1977  
Application for plugging filed (verbally) September 10, 1977  
Application for plugging approved (verbally) September 10, 1977  
Plugging commenced September 10, 1977  
Plugging completed September 10, 1977  
Reason for abandonment of well or producing formation  
No commercial quantity of oil or gas encountered  
If a producing well is abandoned, date of last production  
19

Was permission obtained from the Conservation Division or  
its agents before plugging was commenced? Yes

Name of Conservation Agent who supervised plugging of this well Leo Massey  
Producing formation Depth to top Bottom Total Depth of Well 4493  
Show depth and thickness of all water, oil and gas formations.

OIL, GAS OR WATER RECORDS

CASING RECORD

FORMATION	CONTENT	FROM	TO	SIZE	PUT IN	PULLED OUT

Describe in detail the manner in which the well was plugged, indicating where the mud fluid  
was placed and the method or methods used in introducing it into the hold. If cement or other  
plugs were used, state the character of same and depth placed, from \_\_\_\_\_ feet to  
\_\_\_\_\_ feet for each plug set.

Set 1st plug at 550' with 70 sacks  
2nd plug at 240' with 20 sacks  
3rd plug at 40' with 10 sacks  
Cemented with 50/50 posmix, 6% gel.  
Plug was down at 3:30 a.m., September 10, 1977

09131977

(If additional description is necessary, use BACK of this sheet)

Name of Plugging Contractor Abercrombie Drilling, Inc.


STATE OF Kansas COUNTY OF Sedgwick, ss.  
Jack L. Partridge, Assistant Secretary-Treasurer (employee of owner) or (owner or operator)  
of the above-described well, being first duly sworn on oath, says: That I have knowledge of  
the facts, statements, and matters herein contained and the log of the above-described well  
as filed and that the same are true and correct. So help me God.

(Signature) Jack Partridge  
801 Union Center, Wichita, Kansas 67202  
(Address)

SUBSCRIBED AND SWORN TO before me this 12th day of September, 1977

Sandra Richman  
Sandra Richman Notary Public.

My commission expires July 21, 1979

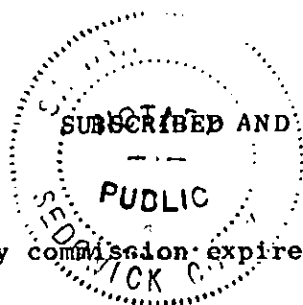

CONTRACTOR'S WELL LOG 15-135-21356 00-00

OPERATOR: Theodore Leben & Assoc.  
 CONTRACTOR: Abercrombie Drilling, Inc.  
 WELL NAME: Humburg "A" #2  
 LOCATION: C NW NE Section 35-18S-25W  
 Ness County, Kansas  
 SPUD DATE: August 31, 1977  
 COMPLETION DATE: September 10, 1977

0	420	Clay, sand & shale
420	1265	Shale
1265	1685	Sand & shale
1685	1730	Anhydrite
1730	3133	Shale
3133	3381	Shale & lime
3381	3496	Lime
3496	3920	Lime & shale
3920	4493	Lime
	4493	Rotary Total Depth

Spud hole at 5:00 p.m., August 31, 1977. Drilled 420' of 12 1/4" hole, ran 10 joints of 8-5/8" (new, 28#) surface casing, set at 417' K.B. Cemented with 300 sacks common cement, 2% gel, 3% CaCl. Cement did circulate. Plug was down at 12:15 a.m., September 1, 1977.

T.D. 4493. Set 1st plug at 550' with 70 sacks, 2nd plug at 240' with 20 sacks, 3rd plug at 40' with 10 sacks. Cemented with 50/50 posmix, 6% gel. Plug was down at 3:30 a.m., September 10, 1977.

SAMPLE TOPS:

Anhydrite 1685'  
 B/Anydrite 1730'

STATE OF KANSAS  
 COUNTY OF SEDGWICK

Jack L. Partridge, Assistant Secretary-Treasurer of Abercrombie Drilling, Inc., does hereby state that the above and foregoing is a true and correct copy of the log of the Humburg "A" #2, C NW NE Section 35-18S-25W. Ness County, Kansas.

ABERCROMBIE DRILLING, INC.

By Jack L. Partridge  
 Jack L. Partridge Ass't. Sec.-Treas.

Subscribed and sworn to before me, a Notary Public, in and for the county and state aforesaid, as of this 12th day of September, 1977.

My commission expires July 21, 1979.

Sandra Richman  
 Sandra Richman, Notary Public

09-13-1977