

STATE OF KANSAS
STATE CORPORATION COMMISSION

RECEIVED

JUL 8 1980
PALOMINO
PETROLEUM
WELL PLUGGING RECORD

Give All Information Completely
Make Required Affidavit
Mail or Deliver Report to
Conservation Division
State Corporation Comm.
245 North Water
Wichita, KS 67202

County. Sec. 19 Twp. 18S Rge. 25W E/W
Location as "NE/CNW 1/4 SW 1/4" or footage from lines
C S/2 NW


Lease Owner Palomino and Darrah
Lease Name Whipple Well No. #1
Office Address 500 Insurance Building, Wichita, Kansas 67202
Character of Well (Completed as Oil, Gas or Dry Hole) dry hole

Date Well completed June 28, 1980 19
Application for plugging filed June 27, 1980 19
Application for plugging approved June 27, 1980 19
Plugging commenced June 27, 1980 19
Plugging completed June 28, 1980 19
Reason for abandonment of well or producing formation dry hole

If a producing well is abandoned, date of last production 19

Was permission obtained from the Conservation Division or its agents before plugging was commenced? yes

Name of Conservation Agent who supervised plugging of this well Marion Schmidt
Producing formation Depth to top Bottom Total Depth of Well 4468'
Show depth and thickness of all water, oil and gas formations.

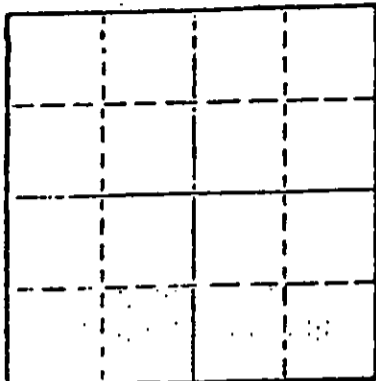

Locate well correctly on above Section Plot

OIL, GAS OR WATER RECORDS

CASING RECORD

FORMATION	CONTENT	FROM	TO	SIZE	PUT IN	PULLED OUT

Describe in detail the manner in which the well was plugged, indicating where the mud fluid was placed and the method or methods used in introducing it into the hold. If cement or other plugs were used, state the character of same and depth placed, from feet to feet for each plug set.

Hole plugged with 50-50 pozmix, 6% gel, as follows: 60 sacks @ 1150', 30 sacks @ 270', hulls and 10 sacks @ 40'. Job completed at 12:15 a.m., June 28, 1980

07-18-1980
RECEIVED
STATE CORPORATION COMMISSION
JUL 18 1980
CONSERVATION DIVISION
Wichita, Kansas

(If additional description is necessary, use BACK of this sheet)

Name of Plugging Contractor Strata Drilling Company


STATE OF KANSAS COUNTY OF BARTON ss.
Charles W. Steincamp (employee of owner) or (owner or operator)
of the above-described well, being first duly sworn on oath, says: That I have knowledge of the facts, statements, and matters herein contained and the log of the above-described well as filed and that the same are true and correct. So help me God.

(Signature) Charles W. Steincamp
P. O. Box 355, Great Bend, Kansas 67530
(Address)

SUBSCRIBED AND SWORN TO before me this 7th day of July, 1980.

Loneita Barry Notary Public.

My commission expires 3-28-84

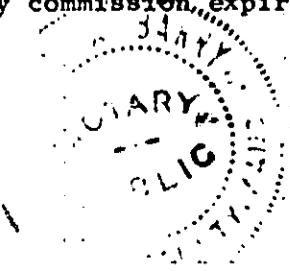

RECEIVED
JUL 8 1980
PALOMINO
PETROLEUM

15-135-21823-00-00

D R I L L E R S L O G

#1 Whipple

CASING RECORD
9 jts. new 24#
8-5/8" surface
casing.

COMPANY: Palomino & Darrah
CONTRACTOR: Strata Drilling Company
COMMENCED: June 19, 1980
COMPLETED: June 28, 1980

DESCRIPTION: C S/2 NW
Section 19-18S-25W
Ness County, Kansas
ELEVATION: 2520' KB

TOTAL ROTARY
DEPTH:

D & A

<u>FORMATION</u>	<u>FROM</u>	<u>TO</u>	<u>REMARKS</u>
Surface soil, shale	0	300	Ran 286' new 24# 8-5/8" surface casing; set and cemented at 291' with 185 sacks common cement, 2% gel, 3% C.C. Cement circulated. Plug down at 4:00 a.m., June 20, 1980.
Shale and sand	300	1780	
Anhydrite	1780	1815	
Shale, shells	1815	2070	
Lime and shale	2070	3450	
Lime	3450	3620	
Lime and shale	3620	4340	
Fort Scott	4340	4375	
Lime and shale	4375	4420	
Lime	4420	4468	
			Ran 3 drill stem tests.
			Hole plugged with 50-50 pozmix, 6% gel, as follows: 60 sacks @ 1150', 30 sacks @ 270', hulls and 10 sacks @ 40'. Plugging completed at 12:15 a.m., June 28, 1980.

STATE OF KANSAS)
) ss
COUNTY OF BARTON)

RECEIVED
STATE CORPORATION COMMISSION
JUL 18 1980
CONSERVATION DIVISION
Wichita, Kansas

07-18-1980

I certify that this is a true and correct copy of the above log to the best of my knowledge.

STRATA DRILLING COMPANY

Charles W. Steincamp
Charles W. Steincamp

Sworn to and subscribed before me this 7th day of July, 1980.

My appointment expires 3-28-84.

Loneita Barry
Loneita Barry, Notary Public

