


15-135-30193-00-00

WELL PLUGGING RECORD

Give All Information Completely  
Make Required Affidavit  
Mail or Deliver Report to:  
Conservation Division  
State Corporation Commission  
211 No. Broadway  
Wichita, Kansas

Ness County, Sec. 19 Twp. 18N Rge. 25W (W) X  
Location as "NE/CNWxSWx" or footage from lines. C SE SW

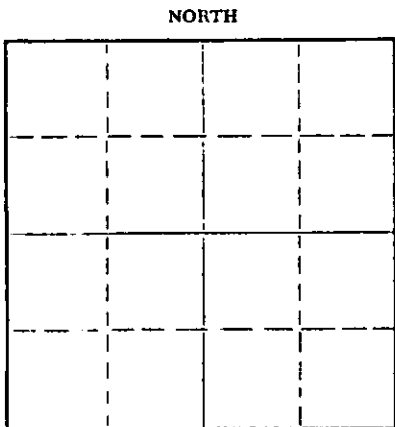

Locate well correctly on above  
Section Plat

Lease Owner Helmerich & Payne, Inc.  
Lease Name Willis Well No. 1  
Office Address Utica at 21st. Tulsa, Oklahoma  
Character of Well (completed as Oil, Gas or Dry Hole)  
Date well completed 19  
Application for plugging filed 3-17-66 19  
Application for plugging approved 3-19-66 19  
Plugging commenced 3-29-66 19  
Plugging completed 4-7-66 19  
Reason for abandonment of well or producing formation

If a producing well is abandoned, date of last production 19  
Was permission obtained from the Conservation Division or its agents before plugging was commenced? Yes

Name of Conservation Agent who supervised plugging of this well Leo F. Massey  
Producing formation Depth to top Bottom Total Depth of Well 4499 Feet  
Show depth and thickness of all water, oil and gas formations.

OIL, GAS OR WATER RECORDS

CASING RECORD

FORMATION	CONTENT	FROM	TO	SIZE	PUT IN	PULLED OUT
				8 5/8	316	None
				5 1/2	None	2526

Describe in detail the manner in which the well was plugged, indicating where the mud fluid was placed and the method or methods used in introducing it into the hole. If cement or other plugs were used, state the character of same and depth placed, from feet to feet for each plug set.

4473 - 4400 Sand  
4400 - 4360 Cement - 5 sacks  
4360 - 336 Heavy drilling mud  
336 - 176 Cement - 50 sacks  
176 - 48 Heavy drilling mud  
48 - 0 Cellar - Cement - 10 sacks

APR 13 1966

CONSERVATION DIVISION  
Wichita, Kansas

04-13-1966

Plugging job completed at 1:00 PM April 7, 1966  
Plugging present.

(If additional description is necessary, use BACK of this sheet)

Name of Plugging Contractor Forbes Casing Pulling, Inc.  
Address P. O. Box 221 Great Bend, Kansas

STATE OF Kansas COUNTY OF Barton, ss.  
J. O. Forbes (employee of owner) or (owner or operator) of the above-described well, being first duly sworn on oath, says: That I have knowledge of the facts, statements, and matters herein contained and the log of the above-described well as filed and that the same are true and correct. So help me God.

(Signature) J. O. Forbes  
P. O. Box 221 Great Bend, Kansas  
(Address)

SUBSCRIBED AND SWORN TO before me this 11 day of April, 1966

My commission expires May 27, 1969

Notary Public.

15-135-30193-00-00

DRILLER'S LOG

Well Owner: Kalmersich & Payne, Inc.  
Farm Name: Willis #1  
Date Started: 11-27-65  
Date Completed: 12-10-65  
Total Depth: 4498

Q SE NW  
Section 19-183-25W  
Nowa County, Kansas

Casings: 2-1/8" set at 316' cemented  
3/4" set at 4498' cemented

Contractor: Peal Brothers, Inc.

Figures below show bottoms of formations:

Shale	0 -	500
Shale and St. Sand		1150
Sand		1900
Shale & Shells		1780
Anhydrite		1815
Shale and Lime		2705
Lime and Shale		3820
Lime		4498
Total Depth		4498

RECEIVED  
STATE OF KANSAS DEPARTMENT OF GEOLOGY

APR 21 1966  
04-21-1966  
CONSERVATION DIVISION  
Wichita, Kansas

This is to certify that the above information is to the best of our knowledge true and correct.

PEAL BROTHERS, INC.

*Wendell G. Peal*  
Wendell G. Peal  
President

SUBSCRIBED AND SWORN to before me this 13th day of December, 1965.

*Ethel S. Williamson*  
Ethel S. Williamson  
Notary Public

My commission expires 6-21-66