

STATE OF KANSAS
STATE CORPORATION COMMISSION

WELL PLUGGING RECORD

Give All Information Completely
Make Required Affidavit
Mail or Deliver Report to
Conservation Division
State Corporation Comm.
245 North Water
Wichita, KS 67202

Ness County, Sec. 25 Twp. 18S Rge. 25 E/W
Location as "NE/CNW/SW" or footage from lines
SE SE NW

Lease Owner Bankoff Oil Co.
Lease Name Sutton Well No. 1

Office Address P.O. Box 2479, Tulsa, Oklahoma 74101

Character of Well (Completed as Oil, Gas or Dry Hole)
Dry Hole

Date Well completed Sept. 18 1977
Application for plugging filed (verbally) Sept. 18 1977
Application for plugging approved (verbally) Sept. 18 1977
Plugging commenced Sept. 18 1977
Plugging completed Sept. 18 1977

Reason for abandonment of well or producing formation
No commercial quantity of oil or gas encountered


If a producing well is abandoned, date of last production
19

Was permission obtained from the Conservation Division or
its agents before plugging was commenced? Yes

Name of Conservation Agent who supervised plugging of this well Leo Massey

Producing formation Depth to top Bottom Total Depth of Well 4461

Show depth and thickness of all water, oil and gas formations.

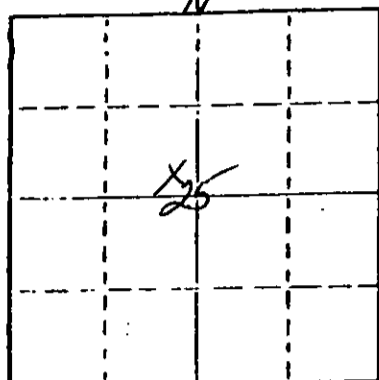

Locate well correctly on above
Section Plot

OIL, GAS OR WATER RECORDS

CASING RECORD

FORMATION	CONTENT	FROM	TO	SIZE	PUT IN	PULLED OUT

Describe in detail the manner in which the well was plugged, indicating where the mud fluid was placed and the method or methods used in introducing it into the hold. If cement or other plugs were used, state the character of same and depth placed, from feet to feet for each plug set.

Set 1st plug at 720' with 70 sacks

2nd plug at 240' with 20 sacks

3rd plug at 40' with 10 sacks

Cemented with 50/50 posmix, 6% gel

Plug was down at 8:30 p.m., September 18, 1977

09-26-1977

(If additional description is necessary, use BACK of this sheet)

Name of Plugging Contractor Abercrombie Drilling, Inc.

STATE OF KANSAS COUNTY OF SEDGWICK ss.

Jack L. Partridge, Ass't. Sec. -Treas. (employee of owner) or (owner or operator) of the above-described

well, being first duly sworn on oath, says: That I have knowledge of the facts, statements, and matters herein contained and the log of the above-described well as filed and that the same are true and correct. So help me God.

(Signature) Jack L. Partridge

801 Union Center, Wichita, Kansas 67202


(Address)

SUBSCRIBED AND SWORN TO before me this 22nd day of September, 1977

July 21, 1979

Sandra Richman

Notary Public.

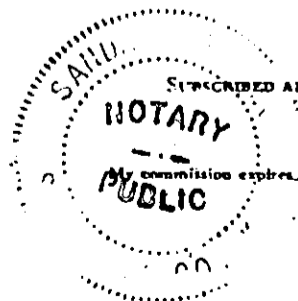

OPERATOR: Bankoff Oil Co.
 CONTRACTOR: Abercrombie Drilling, Inc.
 WELL NAME: Sutton #1
 LOCATION: SE SE NW Section 25-18S-25W
 Ness County, Kansas
 SPUD DATE: September 12, 1977
 COMPLETION DATE: September 18, 1977

0	405	Sand, clay, shale
405	630	Shale & sand
630	1180	Sand & shale
1180	1380	Sand
1380	1715	Sand & shale
1715	1739	Anhydrite
1739	1987	Shale
1987	2298	Shale & lime
2298	2828	Shale
2828	3117	Shale & lime
3117	3341	Lime
3341	3538	Shale & lime
3538	4461	Lime
	4461	Rotary Total Depth

Spud hole at 4:00 p.m., September 12, 1977. Drilled 405' of 12 1/4" hole, ran 10 joints of 8-5/8" casing, set at 402.53'. Cemented with 300 sacks of common cement, 2% gel, 3% CaCl. Chased plug with water at 380', plug was down at 1:15 a.m., September 13, 1977. Cement did circulate.

T.D. 4461. Set 1st plug with 70 sacks at 720'; second plug with 20 sacks at 240' third plug with 10 sacks at 40'. Cemented with 50/50 posmix, 6% gel. Plug was down at 8:30 p.m., September 18, 1977.

SAMPLE TOPS:

Anhydrite 1691' (+720)
 B/Anhydrite 1739' (+672)

09-26-1977


STATE OF KANSAS)
) ss
 COUNTY OF SEDGWICK)

Jack L. Partridge, Assistant Secretary-Treasurer of Abercrombie Drilling, Inc., does hereby state that the above and foregoing is a true and correct copy of the log of the Sutton #1, SE SE NW Section 25-18S-25W, Ness County, Kansas

ABERCROMBIE DRILLING, INC.

By Jack L. Partridge
 Jack L. Partridge, Ass't. Sec.-Treas.

Subscribed and sworn to before me, a Notary Public, in and for the county and state as of this 22nd day of September, 1977.

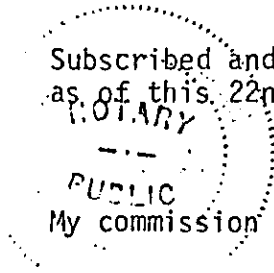

Sandra Richman
 Sandra Richman, Notary Public