


Give All Information Completely  
Make Required Affidavit  
Mail or Deliver Report to:  
Conservation Division  
State Corporation Commission  
212 No. Market  
Wichita, Kansas

WELL PLUGGING RECORD

Ness County, Sec. 26 Twp. 18S Rge. 7 (E 25) (W)  
Location as "NE/CNW&SW" or footage from lines 145' E of C SE SE  
Lease Owner Champlin Petroleum Company  
Lease Name Bondurant Well No. 1  
Office Address P. O. Box 308, Ellinwood, Kansas 67526  
Character of Well (completed as Oil, Gas or Dry Hole) Dry Hole  
Date well completed December 7 19 71  
Application for plugging filed December 7 19 71  
Application for plugging approved (Verbal) December 7 19 71  
Plugging commenced December 7 19 71  
Plugging completed December 7 19 71  
Reason for abandonment of well or producing formation

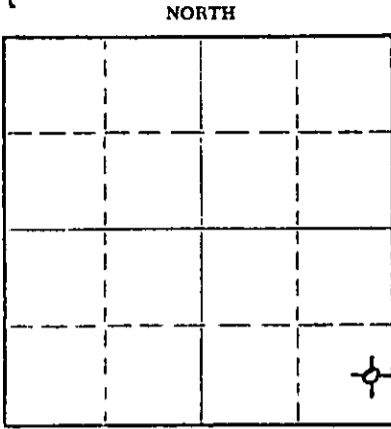

Locate well correctly on above Section Plat

If a producing well is abandoned, date of last production 19  
Was permission obtained from the Conservation Division or its agents before plugging was commenced? Yes

Name of Conservation Agent who supervised plugging of this well Leo Massey  
Producing formation Depth to top Bottom Total Depth of Well 4520 Feet  
Show depth and thickness of all water, oil and gas formations.

OIL, GAS OR WATER RECORDS

CASING RECORD

FORMATION	CONTENT	FROM	TO	SIZE	PUT IN	PULLED OUT
				8 5/8" OD	355'	None

Describe in detail the manner in which the well was plugged, indicating where the mud fluid was placed and the method or methods used in introducing it into the hole. If cement or other plugs were used, state the character of same and depth placed, from feet to feet for each plug set.

Hole was full of heavy rotary mud to 600' then spotted 70 sacks cement at 600', filled with mud to 300' and spotted 20 sacks cement at 300', pushed plug and hulls to 40' and 10 sacks cement to fill hole to bottom of cellar. All cement was 50/50 Pozmix, 6% Gel.

Used Halliburton to pump cement.

RECEIVED  
STATE CORPORATION COMMISSION  
DEC 13 1971  
CONSERVATION DIVISION  
Wichita, Kansas  
12-13-1971

(If additional description is necessary, use BACK of this sheet)  
Name of Plugging Contractor Strata Drilling Company  
Address 2421 10th Street, Great Bend, Kansas 67530

STATE OF Kansas COUNTY OF Barton, ss.  
J. W. Meyers (employee of owner) or (owner) of the above-described well, being first duly sworn on oath, says: That I have knowledge of the facts, statements, and matters herein contained and the log of the above-described well as filed and that the same are true and correct. So help me God.

(Signature) J. W. Meyers, District Operations Manager  
P. O. Box 308, Ellinwood, Kansas  
(Address)

SUBSCRIBED AND SWORN TO before me this 9th day of December, 19 71

My commission expires 4/16/74

M. Kenneth Stone  
Notary Public.

15-135-20515-00-00

D R I L L E R S   L O G

#1 Bondurant

CASING RECORD: 349.32' of new 8-5/8" surface casing.	COMPANY: Champlin Petroleum Company	DESCRIPTION: 145' East of C SE SE Section 26-18S-25W Ness County, Kansas
TOTAL DEPTH: 4520'	CONTRACTOR: Strata Drilling, Inc.	COMPLETED: December 7, 1971
	COMMENCED: November 26, 1971	

D. & A.

<u>FORMATION</u>	<u>FROM</u>	<u>TO</u>	<u>REMARKS</u>
Clay, Post Rock, Shale & Sand	0	375	Ran 349.32' of new 8-5/8" surface casing; set and cemented at 355.32' with 250 sacks of common cement, 3% C. C. and 1 1/2% A. C. Plug down at 12:45 A. M. November 27, 1971.
Shale w/Sand Streaks	375	875	
Red Bed, Shale & Shells	875	1086	
Anhydrite	1086	1103	
Red Bed, Shale & Shells	1103	1110	
Red Bed	1110	1163	
Dakota Sand	1163	1424	
Red Bed, Shale & Shells	1424	1702	
Stone & Anhydrite	1702	1712	
Red Bed & Shale	1712	1722	
#2 Anhydrite	1722	1740	
Lime Streak, Shells, Rock & Shale	1740	1983	
Shale & Shells	1983	2390	
Shale, Lime w/Broken Lime	2390	2577	
Lime, Shale & Shells	2577	2790	
Lime & Shale	2790	3566	
Lime	3566	4132	
Lime & Shale	4132	4222	
Lime	4222	4302	
Cherty Lime & Shale	4302	4450	
Lime	4450	4460	
Cherty Lime	4460	4475	
Lime	4475	4485	
Cherty Lime	4485	4520	

RECEIVED  
STATE CORPORATION COMMISSION  
DEC 13 1971  
CONSERVATION DIVISION  
Wichita, Kansas  
12-13-1971

D. & A.

Plugged hole as follows: Plugged at 600' with 70 sacks of common cement; plugged at 300' with 20 sacks of common cement; plugged at 40' with 10 sacks of common cement. Plug down at 5:00 A. M. December 7, 1971.


STATE OF KANSAS )  
                          ) ss.  
COUNTY OF BARTON)

I certify that this is a true and correct copy of the above log to the best of my knowledge.

STRATA DRILLING, INC.

*Charles W. Steincamp*  
Charles W. Steincamp, President

Subscribed and sworn to before me this 8th day of December, 1971.  
My Commission Expires:  
December 14, 1973

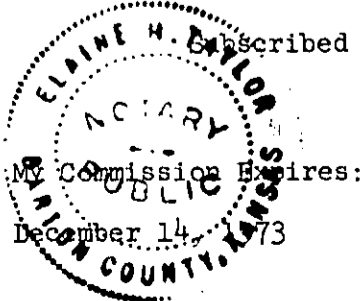

*Elaine H. Taylor*  
Elaine H. Taylor, Notary Public