


STATE OF KANSAS  
STATE CORPORATION COMMISSION

WELL PLUGGING RECORD

Give All Information Completely  
Make Required Affidavit  
Mail or Deliver Report to  
Conservation Division  
State Corporation Comm.  
245 North Water  
Wichita, KS 67202

Ness County. Sec. 17 Twp. 18S Rge. 23 N/W  
Location as "NE/CNW/SW" or footage from lines \_\_\_\_\_

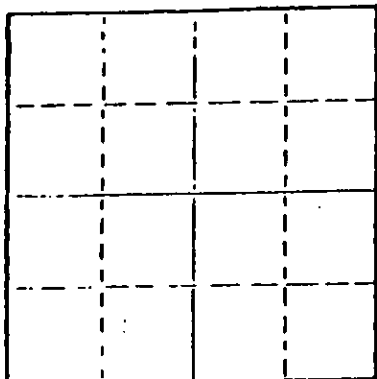

Locate well correctly on above  
Section Plot

C-NW-SE  
Lease Owner Mull Drilling Company  
Lease Name Keller Well No. 3  
Office Address 415 Page Court, 220 W. Douglas, Wichita, Ks.  
Character of Well (Completed as Oil, Gas or Dry Hole) \_\_\_\_\_  
Dry Hole

Date Well completed 7-29 1976  
Application for plugging filed 7-29 1976  
Application for plugging approved 7-29 1976  
Plugging commenced 7-29 1976  
Plugging completed 7-29 1976  
Reason for abandonment of well or producing formation \_\_\_\_\_

Dry Hole  
If a producing well is abandoned, date of last production \_\_\_\_\_ 19\_\_\_\_

Was permission obtained from the Conservation Division or its agents before plugging was commenced? Yes

Name of Conservation Agent who supervised plugging of this well \_\_\_\_\_  
Producing formation \_\_\_\_\_ Depth to top \_\_\_\_\_ Bottom \_\_\_\_\_ Total Depth of Well \_\_\_\_\_  
Show depth and thickness of all water, oil and gas formations.

OIL, GAS OR WATER RECORDS

CASING RECORD


FORMATION	CONTENT	FROM	TO	SIZE	PUT IN	PULLED OUT
<u>Surface Report</u>		<u>-0-</u>	<u>397'</u>	<u>8 5/8"</u>	<u>397'</u>	<u>None</u>

Describe in detail the manner in which the well was plugged, indicating where the mud fluid was placed and the method or methods used in introducing it into the hold. If cement or other plugs were used, state the character of same and depth placed, from \_\_\_\_\_ feet to \_\_\_\_\_ feet for each plug set.

Filled hole with 85 sks. common cement with 4% Gel.

- #1 Plug set @ 550' with 50 sacks cement
- #2 plug set @ 300' with 25 sacks cement
- #3 Plug set @ 40' with 10 sacks cement

Plugging time 10:30 A.M. to 11:30 A.M.

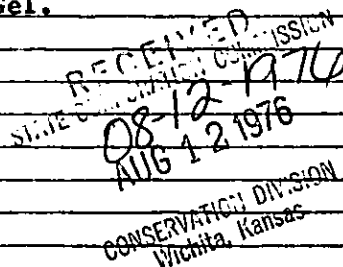

(If additional description is necessary, use BACK of this sheet)

Name of Plugging Contractor Blue Goose Drilling Co., Inc.  
Box 1413, Great Bend, Kansas 67530

STATE OF Kansas COUNTY OF Barton ss.


George E. Miller, Jr. (Notary Public) or (owner or operator) of the above-described well, being first duly sworn on oath, says: That I have knowledge of the facts, statements, and matters herein contained and the log of the above-described well as filed and that the same are true and correct. So help me God.

(Signature) George E. Miller, Jr.  
Box 1413, Great Bend, Kansas  
(Address)

Subscribed and Sworn to before me this 11th day of August, 1976

Day J. Furrh  
Notary Public.

My commission expires 7-10-77

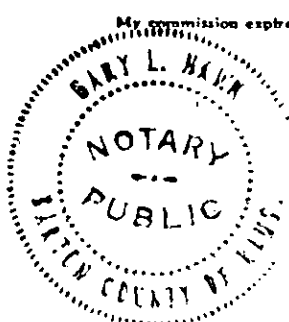

15-135-21229-00-00

WELL LOG  
Keller #3  
17-18S-23W  
Ness County, Kansas

Name of Operator: Mull Drilling Co.  
415 Page Court  
220 W. Douglas  
Wichita, Kansas 67202

Date Completed: July 29, 1976

FROM	TO	
0	40	Surface Clay
40	200	Shale
200	220	Sand
220	402	Shale and Shells
402	1804	Shale and Sand
1804	2430	Shale
2430	2595	Shale and shells
2595	3875	Shale and lime
3875	4369	Lime
4369		Total Depth

RECEIVED  
STATE COMMISSION ON CONSERVATION

AUG 12 1976  
CONSERVATION DIVISION  

08-12-1976

STATE OF KANSAS

COUNTY OF BARTON ss

George E. Miller, Jr., President of Blue Goose Drilling Co., Inc.,  
being first duly sworn on oath says: That I have knowledge of the facts, statements  
and matters herein contained and the log of the above described well as filed  
and that the same are true and correct.

*George E. Miller Jr.*  
George E. Miller, Jr.

Subscribed and sworn before me this 5th day of August, 1976.

*Gary L. Hawk*  
Notary Public Barton County

My Commission Expires: 7-10-77

