


STATE OF KANSAS
STATE CORPORATION COMMISSION

Form CP-4

Give All Information Completely
Make Required Affidavit
Mail or Deliver Report to:
Conservation Division
State Corporation Commission
211 No. Broadway
Wichita, Kansas

WELL PLUGGING RECORD

Rush County. Sec. 22 Twp. 16 S Rge. 16 ~~W~~ (W)
Location as "NE/CNW&SW" or footage from lines NW NE NE/4
Lease Owner Icer Addis
Lease Name F. Carl Dietz Well No. 1
Office Address P. O. Box 519, Great Bend, Kansas 67530
Character of Well (completed as Oil, Gas or Dry Hole) Dry Hole
Date well completed May 2, 19 68
Application for plugging filed May 2, 19 68
Application for plugging approved May 2, (by phone) 19 68
Plugging commenced May 2, 19 68
Plugging completed May 3, 19 68
Reason for abandonment of well or producing formation Dry Hole

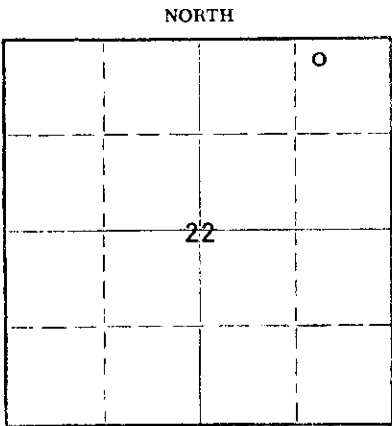

Locate well correctly on above
Section Plat

If a producing well is abandoned, date of last production -- 19 --
Was permission obtained from the Conservation Division or its agents before plugging was commenced? Yes - by telephone

Name of Conservation Agent who supervised plugging of this well Leo Massey, Hays, Kansas
Producing formation _____ Depth to top _____ Bottom _____ Total Depth of Well 3530 Feet
Show depth and thickness of all water, oil and gas formations.

OIL, GAS OR WATER RECORDS

CASING RECORD

FORMATION	CONTENT	FROM	TO	SIZE	PUT IN	PULLED OUT

Describe in detail the manner in which the well was plugged, indicating where the mud fluid was placed and the method or methods used in introducing it into the hole. If cement or other plugs were used, state the character of same and depth placed, from _____ feet to _____ feet for each plug set.
Filled with mud to 400'.
Set plug and 25 sacks cement.
Filled with mud to 40'.
Filled to bottom of cellar with cement.

RECEIVED
STATE CORPORATION COMMISSION
MAY 10 1968
CONSERVATION DIVISION
Wichita, Kansas

(If additional description is necessary, use BACK of this sheet)
Name of Plugging Contractor Omega Drilling, Inc.
Address 427 Union Center, Wichita, Kansas 67202

STATE OF Kansas, COUNTY OF Sedgwick, ss.
F. S. Woodside, Jr., contractor (employee of owner) or (owner or operator) of the above-described well, being first duly sworn on oath, says: That I have knowledge of the facts, statements, and matters herein contained and the log of the above-described well as filed and that the same are true and correct. So help me God.

(Signature) F. S. Woodside, Jr.
427 Union Center, Wichita, Kansas 67202
(Address)

SUBSCRIBED AND SWORN TO before me this 7th day of May, 19 68.

Mary L. Lawrence
Mary L. Lawrence, Notary Public.
My commission expires February 27, 1971

ROTARY DRILLING LOG

Operator: Icer Addis
#1 F. Carl Dietz
NW NE NE/4 22-16S-16W
Rush County, Kansas

Contractor: Omega Drilling, Inc.
Commenced: December 18, 1967
Drilled to 1161' and
shut down on
December 20, 1967.
Moved off location.
April 24, 1968 moved
rig back on location.
Completed: May 3, 1968

Casing Record:
13" casing cemented at 231'
with 250 sacks cement.
8 5/8" casing cemented at
1008' with 500 sacks cement.

FORMATIONS

984	Shale and shells
1002	Shale
1031	Anhydrite
1161	Shale
1196	Shale and shells
1893	Shale and lime
1915	Shale
3215	Lime and shale
3417	Lime
3530	Lime and Conglomerate
3530	Rotary Total Depth

RECEIVED
STATE CORPORATION COMMISSION
MAY 10 1968
CONSERVATION DIVISION
Wichita, Kansas

We certify that the above log is true and correct to the best of our knowledge and belief.

OMEGA DRILLING, INC.

By *F. S. Woodside, Jr.*
F. S. Woodside, Jr.
President

Subscribed and sworn to before me, a Notary Public, in and for the State of Kansas, County of Sedgwick, this 7th day of May, 1968.

Mary L. Lawrence
Mary L. Lawrence, Notary Public

My commission expires February 28, 1971.