


STATE OF KANSAS
STATE CORPORATION COMMISSION

WELL PLUGGING RECORD

Give All Information Completely
Make Required Affidavit
Mail or Deliver Report to
Conservation Division
State Corporation Comm.
245 North Water
Wichita, KS 67202

Rush County. Sec. 22 Twp. 16 Rge. 16 ^{NE}/₄
Location as "NE/CNW¹/₄SW¹/₄" or footage from lines _____
NW SE NW
Lease Owner LaVern Becker
Lease Name Wegele Well No. 2
Office Address Rt. #2 Russell, Kansas 67665
Character of Well (Completed as Oil, Gas or Dry Hole) X

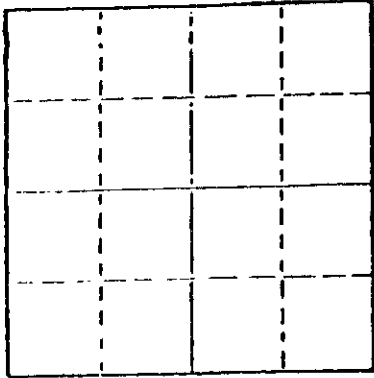

Locate well correctly on above
Section Plat

Date Well completed Nov. 21 1980
Application for plugging filed Nov. 21 1980
Application for plugging approved Nov. 21 1980
Plugging commenced Nov. 21 1980
Plugging completed Nov. 21 1980
Reason for abandonment of well or producing formation
dry
If a producing well is abandoned, date of last production 19 _____

Was permission obtained from the Conservation Division or
its agents before plugging was commenced? yes

Name of Conservation Agent who supervised plugging of this well Leo Massey
Producing formation _____ Depth to top _____ Bottom _____ Total Depth of Well 3525
Show depth and thickness of all water, oil and gas formations.

OIL, GAS OR WATER RECORDS

CASING RECORD

FORMATION	CONTENT	FROM	TO	SIZE	PUT IN	PULLED OUT
				8 5/8	1027	

Describe in detail the manner in which the well was plugged, indicating where the mud fluid was placed and the method or methods used in introducing it into the hold. If cement or other plugs were used, state the character of same and depth placed, from _____ feet to _____ feet for each plug set.

1st plug 1020 w/60sx
2nd plug 360 w/30sx
3rd plug 40 w/10sx

5 sx in rathole

(If additional description is necessary, use BACK of this sheet) ^{DEC 6 1980}

Name of Plugging Contractor Woodman & Iannitti Drilling Co. CONSERVATION DIVISION
Wichita, Kansas

STATE OF KANSAS COUNTY OF SEDGWICK, ss.
K. T. Woodman (employee of owner) or (owner or operator
of the above-described well, being first duly sworn on oath, says: That I have knowledge of
the facts, statements, and matters herein contained and the log of the above-described well
as filed and that the same are true and correct. So help me God.

(Signature) K. T. Woodman
1008 Douglas Bldg. Wichita, Kansas 67202
(Address)

SUBSCRIBED AND SWORN TO before me this 1st day of December, 19 80

My commission expires Feb. 11, 1984

Justina Chamberlain
Justina Chamberlain Notary Public.

15.165.20816-0000

K. T. WOODMAN
RES. PHONE 733-0418
OFF. PHONE 265-7650
WICHITA, KANSAS

D. J. IANNITTI
PHONE 792-2921
GREAT BEND, KANSAS

WOODMAN & IANNITTI DRILLING COMPANY

Rotary Drilling Contractors

1008 DOUGLAS BUILDING
104 S. BROADWAY
WICHITA, KANSAS 67202

November 26, 1980

Company;	LaVern Becker
Farm;	#2 Wegele
Location;	NW SE NW
Section;	22-16 16W
County;	Rush
Contractor;	Woodman & Iannitti Drilling Co.
Comm;	November 15, 1980
Compl;	November 21, 1980
Total Depth;	3525
Casing;	8 5/8 @ 1027 w/250 sx.
Production;	D & A

Figures Indicate Bottom Of Formations;

350	Post rock, shale & sand
699	Post rock, shale & sand
1020	Surface hole
1029	Anhy
1045	Anhy
1820	Shale
2836	Lime & shale
3290	Lime & shale
3477	Lime & shale
3525	Lime

I certify the above to be a true and correct copy of the drillers log to the best of my knowledge and belief

Woodman & Iannitti Drilling Co.

K. T. Woodman
K. T. Woodman

DEC - 2, 1980

CONSERVATION DIVISION
Wichita, Kansas