


15-165-30137-0000

DR

STATE OF KANSAS
STATE CORPORATION COMMISSION

Give All Information Completely
Make Required Affidavit
Mail or Deliver Report to:
Conservation Division
State Corporation Commission
212 North Market, Insurance Bldg.
Wichita, Kansas

WELL PLUGGING RECORD

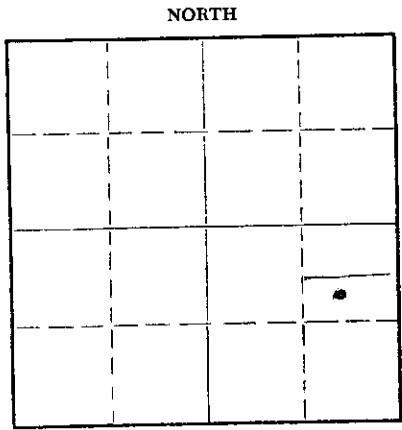

Locate well correctly on above
Section Plat

RUSH County. Sec. 24 Twp. 16 Rge. 16 (E) (W)
Location as "NE/CNW/SW" or footage from lines C S/2 NE SE
Lease Owner Hummon Oil, Inc.
Lease Name Maier Well No. 1
Office Address Wichita, Kansas
Character of Well (completed as Oil, Gas or Dry Hole) Dry Hole
Date well completed October 6 19 66
Application for plugging filed October 6 19 66
Application for plugging approved October 6 19 66
Plugging commenced October 6 19 66
Plugging completed October 6 19 66
Reason for abandonment of well or producing formation Dry Hole

If a producing well is abandoned, date of last production 19
Was permission obtained from the Conservation Division or its agents before plugging was commenced? Yes

Name of Conservation Agent who supervised plugging of this well Leo Massey
Producing formation Depth to top Bottom Total Depth of Well 3576 Feet
Show depth and thickness of all water, oil and gas formations.

OIL, GAS OR WATER RECORDS

CASING RECORD

FORMATION	CONTENT	FROM	TO	SIZE	PUT IN	PULLED OUT

Describe in detail the manner in which the well was plugged, indicating where the mud fluid was placed and the method or methods used in introducing it into the hole. If cement or other plugs were used, state the character of same and depth placed, from feet to feet for each plug set.

Set plug at 400' and spotted 30 sacks of cement
through drill pipe with Halliburton pump truck, Spotted 20 sacks
of cement with Halliburton pump truck at 300'. Set plug and hulls
and 10 sacks of cement at 40'. Put 2 sacks cement in rat hole.

RECEIVED
STATE CORPORATION COMMISSION

OCT 21 1966

CONSERVATION DIVISION
WICHITA, KANSAS

(If additional description is necessary, use BACK of this sheet)
Name of Plugging Contractor BURT DRILLING CO.
Address 1823 Washington, Great Bend, Kansas

STATE OF KANSAS, COUNTY OF BARTON, ss.
Duke C. Burt (employee of owner) or (owner or operator) of the above-described well, being first duly sworn on oath, says: That I have knowledge of the facts, statements, and matters herein contained and the log of the above-described well as filed and that the same are true and correct. So help me God.

(Signature) [Signature]
1823 Washington, Great Bend, Kansas
(Address)

SUBSCRIBED AND SWORN TO before me this 19th day of October, 19 66

My commission expires October 15, 1967
Notary Public.

15.165.38137-0000

HUMMON OIL CO.
~~1101 X Michlica Plaza~~ 821 Union National Building
 Wichita, Kansas

Well: Maier No. 1
 Commenced R. D.: 9/27/66
 Completed R. D.: 10-7-66
 Total Depth: 3576'
 Casing: 325' of 8 5/8 8rd thd. 24#
 Surface Pipe

Sec.: 24-16S-16W
 Barton County, Kansas
 Elevation:
 Initial Prod.: D & A
 Contractor: BURT DRILLING
 COMPANY

Strata	Depth
Post Rock	0- 90'
Shale & Shels	90- 219
Sand	219- 250
Shale & Shells	250-1045
Shale & Lime	1045-1070
Shale & Shells	1070-1743
Shale & Lime	1743-2400
Shale w/Lime Streaks	2400-2790
Shale & Lime	2790-2906
Shale w/Lime Streaks	2906-2958
Lime & Shale	2958-3066
Lime	3066-3185
Heebner	3185-3189
Lime & Shale	3189-3222
Shale & Lime	3222-3250
Lime	3250-3453
Lime & Shale (Conglomerate)	3453-3480
Sandy Lime	3480-3512
Lime	3512-3576
Arbuckle	3576'


RECEIVED
 STATE CORPORATION COMMISSION
 OCT 21 1966
 CONSERVATION DIVISION
 Wichita, Kansas

I hereby certify that the above is a true and correct log of said well as reflected by daily reports.

BURT DRILLING CO.



Signed and sworn in my presence this 10th day of October, 1966.

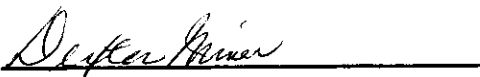

My Commission Expires: Oct. 15, 1967