

K-165-01897-0000

STATE OF KANSAS
STATE CORPORATION COMMISSION

WELL PLUGGING RECORD


OR

FORMATION PLUGGING RECORD

Strike out upper line
when reporting plug-
ging off formations.

Give All Information Completely
Make Required Affidavit
Mail or Deliver Report to:
Conservation Division
State Corporation Commission
800 Bitting Building
Wichita, Kansas

NORTH

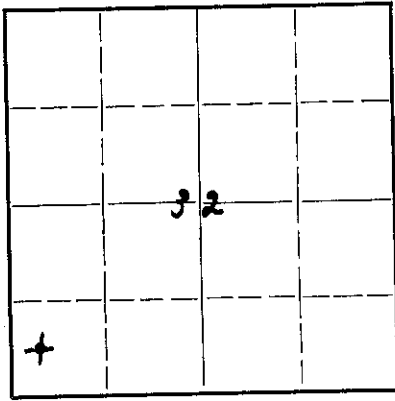

Locate well correctly on above
Section Plat

Rush County, Sec. 32 Twp. 14 Rge. (E) 14 (W)
Location as "NE 1/4 NW 1/4 SW 1/4" or footage from lines Center of west line S.W. S.W.
Lease Owner Bird, Hanley & Shedy
Lease Name Allen
Office Address 407 Kaufman Bldg. Wichita, Kansas
Character of Well (completed as Oil, Gas or Dry Hole) Dry - Hole
Date well completed January - 10 1943
Application for plugging filed January 19
Application for plugging approved 19
Plugging commenced January - 11 1943
Plugging completed 19
Reason for abandonment of well or producing formation no oil found
in Producing formations
If a producing well is abandoned, date of last production 19
Was permission obtained from the Conservation Division or its agents before plugging was com-
menced? yes

Name of Conservation Agent who supervised plugging of this well C. T. Alexander
Producing formation Depth to top Bottom Total Depth of Well 367.5 Feet

Show depth and thickness of all water, oil and gas formations.

OIL, GAS OR WATER RECORDS


CASING RECORD

Formation	Content	From	To	Size	Put In	Pulled Out
Sand -	Water	520	725	12 1/2"	273'	

Describe in detail the manner in which the well was plugged, indicating where the mud fluid was placed and the method or methods used in introducing it into the hold. If cement or other plugs were used, state the character of same and depth placed, from _____ feet to _____ feet for each plug set.

Well was plugged with Rotary mud weighing 14.9 lbs. Pumped through drill pipe. The mud was circulated back 500' as drill pipe was pulled and at 500 feet from top of hole a Haliburton Plug was Run and Cemented with 40 sacks of Cement by Haliburton, then mud was pumped in well to 2 1/2 feet of surface where wood Plug was driven and Cemented with 21 sacks of Cement to 1/2 feet of surface by Haliburton. Plugging was completed at 9 am. 1/11/43

PLUGGING
FILE SEC 32 T 14 R 14 W
BOOK PAGE 10 LINE 32

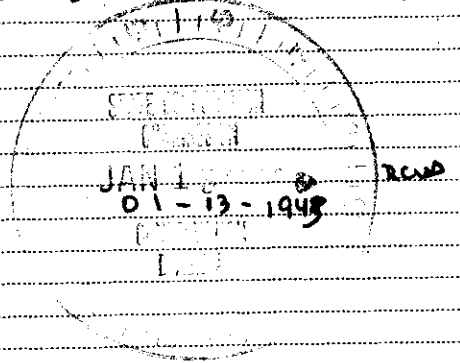

(If additional description is necessary, use BACK of this sheet)

Correspondence regarding this well should be addressed to Bird, Hanley & Shedy
Address 407 Kaufman Bldg. Wichita, Kansas

STATE OF KANSAS COUNTY OF SEDGWICK, ss.

George P. Pyeatte

(employee of owner) ~~XXXXXXXXXXXX~~ of the above-described well,

being first duly sworn on oath, says: That I have knowledge of the facts, statements, and matters herein contained and the log of the above-described well as filed and that the same are true and correct. So help me God.

(Signature)

George P. Pyeatte
407 Kaufman Bldg., Wichita, Kansas
(Address)

SUBSCRIBED AND SWORN TO before me this 13th day of January 1943

Emory W. Whitcomb
Notary Public.

My commission expires November 25, 1943



Log of Bird - Hanley & Shady - well #1
 Center of west line of SW. SW. 32-14-16W Bush Co. Kan.

Commenced well - 12/16/42 -

Completed well - 1/11/43 -

Contractor - Simpson & Noble. (Retired)

Depth	Formation
0 - 319	Rock and Shale -
319 - 385	Shells -
385 - 520	Shale -
520 - 725	Sand -
725 - 750	Red-Rock -
750 - 790	Sand
790 - 960	Shale -
960 - 1100	Red - Red
1100 - 1135	Lime
1135 - 1256	Shale
1256 - 1473	Shale - Shells & sand
1473 - 1570	Shale & sand
1570 - 1810	Shale & salt
1810 - 1840	Shale & Shells -
1840 - 2197	Broken Lime
2197 - 2466	Lime
2466 - 2592	Shale
2592 - 2688	Shale & Shells -
2688 - 2816	Shale -
2816 - 2875	Lime
2875 - 3081	Broken - Lime
3081 - 3125	Lime
3125 - 3133	Shale -
3133 - 3274	Broken Lime
3274 - 3302	Shale & Red-Rock -
3302 - 3307	Shale -
3307 - 3555	Lime -
3555 - 3594	varied Shales -
3594 - 3603	Conglomerate & Chert
3603 - 3675	Lime - Arbuckle -
3675 -	Total Depth -

PLUGGING
 FILE SEC 32-T-14-R14W
 BOOK PAGE 40-LINE 29

K. 165 · 01897-0000
Plugging Instructions

How Well Shall Be Plugged

Date 1-10- 1943

Location NE 1/4 SW

Sec. 31 Twp. 16 Rge. 16 W

Operators Bird Hamley & Shuck

Address 407 Kaufman Building Wichita

Lease Allin Well No. 1 County Rush

Total Depth 3660 ft. P. B. to _____ ft.

The hole shall be filled with mud or cement from 3660 ft.

to 500 ft. and mud, rock and bridge to 500 ft.

and cement to 440-15.5 in ft. and mud, rock and bridge to

26 ft. and cement to 6 ft. and mud, rock

and bridge to _____ ft. and cement to _____ ft.

and mud to top of surface.

A rotary drilled dry hole that has only the surface pipe lift in the hole shall be filled with heavy rotary pit mud or mud and cement up to the bottom of the surface pipe or at approximately (50) below the fresh water, where the hole shall be bridged and cemented and then filled with extra heavy mud and cement to top of surface.


The operator shall have the option as to the method of placing cement in hole by: (a) dump bailer, (b) pumped through tubing, (c) pump and plug.

Pipe in hole 12 in. 273 ft. _____ in. _____ ft.

_____ in. _____ ft. _____ in. _____ ft.

PLUGGING
FILE SEC 32T-16-R16W
BOOK PAGE 60 LINE 39

(Signed) E. T. Alexander

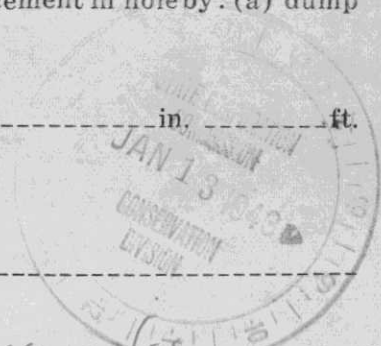

BIRD-HANLEY & SHEEDY

407 KAUFMAN BLDG. WICHITA, KANSAS TELEPHONE 4-7412

Nº 6871

DATE _____ 194__

INVOICE DATE

STATEMENT OF ACCOUNT COVERED BY THIS CHECK. IF IN ERROR
RETURN FOR CORRECTION

AMOUNT

Plugging cost on Allen NW SW SW 32-16-16W, Rush, Co

25.00

Payee will detach this statement before depositing, endorsement on check being sufficient receipt.