


K-165-01904-0000

WELL PLUGGING RECORD

Give All Information Completely
Make Required Affidavit
Mail or Deliver Report to:
Conservation Division
State Corporation Commission
800 Bittling Building
Wichita, Kansas

Rush County, Sec. 1 Twp. 16 Rge. 18 (E) W (W)
Location as "NE/CNW/SW 1/4" or footage from lines NE/4 NE/4 NE/4
Lease Owner Transit Corporation
Lease Name Gottschalk Well No. 1
Office Address 1516 Liberty Bank Bldg., Oklahoma City, Okla.
Character of Well (completed as Oil, Gas or Dry Hole) Dry Hole
Date well completed 4-22-1952
Application for plugging filed 4-22-1952
Application for plugging approved 4-22-1952
Plugging commenced 4-22-1952
Plugging completed 4-22-1952
Reason for abandonment of well or producing formation

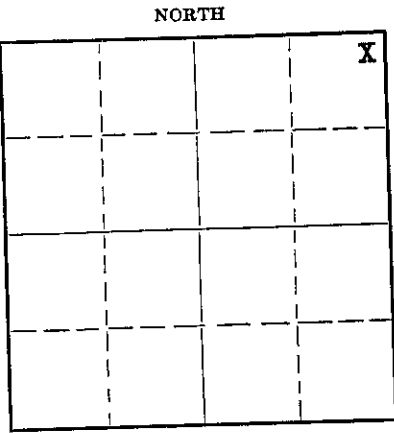

Locate well correctly on above Section Plat

If a producing well is abandoned, date of last production 19...
Was permission obtained from the Conservation Division or its agents before plugging was commenced? Yes
Name of Conservation Agent who supervised plugging of this well Eldon Petty

Producing formation... Depth to top... Bottom... Total Depth of Well 3505 Feet
Show depth and thickness of all water, oil and gas formations.

CASING RECORD

Formation	Content	From	To	Size	Put In	Pulled Out
				8-5/8	1070	None

Describe in detail the manner in which the well was plugged, indicating where the mud fluid was placed and the method or methods used in introducing it into the hole. If cement or other plugs were used, state the character of same and depth placed, from... feet to ... feet for each plug set.

Filled Hole to 300' with heavy drilling mud, set plug and cemented with 100 sacks to bottom of cellar.

APR 20 1952
CONSERVATION DIVISION
WICHITA, KANSAS

(If additional description is necessary, use BACK of this sheet)
Name of Plugging Contractor Transit Corporation
Address 1516 Liberty Bank Building, Oklahoma City, Oklahoma

STATE OF Oklahoma, COUNTY OF Oklahoma, ss.
L. J. Kruse (employee of owner) of the above-described well,
being first duly sworn on oath, says: That I have knowledge of the facts, statements, and matters herein contained and the log of the above-described well as filed and that the same are true and correct. So help me God

(Signature) L. J. Kruse
Oklahoma City, Oklahoma (Address)

SUBSCRIBED AND SWORN to before me this 25th day of April, 1952

Lillian Wright
Notary Public

My commission expires October 24, 1955
23-8390-s 6-51-20M

PLUGGING
FILE SEC 2 T 16 R 18 C
BOOK PAGE 44 LINE 2

15-165-01904-0000

TRANSIT CORPORATION & ELLIOTT DAVIS

GOTTSCHALK # 1

NE/4 NE/4 NE/4 Sec. 1-16S-18W
Rush County, Kans.

<u>FORMATION</u>	<u>FROM</u>	<u>TO</u>	<u>REMARKS</u>
Surface Clay & Sand	0	40	
Black Shale	40	410	
Blue Shale & Sand	410	594	
Sand	594	715	
Red Bed	715	1030	
Red & Blue Shale	1030	1060	
Anhydrite	1060	1090	8-5/8" C.S.A. @ 1071'. Cemented
Anhydrite Blue Shale	1090	1480	650 sacks cement.
Gumbo & Shale	1480	1762	
Shale & Lime	1762	2190	
Lime & Shale	2190	2410	
Shale & Lime	2410	2545	
Shale & Shells	2545	2595	
Shale	2595	2675	
Shale & Shells	2675	2770	
Lime & Shale	2770	2890	
Shale & Lime	2890	2960	
Lime & Shale	2960	3000	
Shale & Lime	3000	3010	
Lime	3010	3060	
Lime & Shale	3060	3290	
Lime	3290	3330	
Lime	3330	3368	
Lime	3368	3505	
Lime & Shale			
Total Depth		3505'	

I hereby certify the foregoing to be a true and accurate Driller's Log of the formations encountered in the above well.

TRANSIT CORPORATION

By: L. J. Kruse
L. J. Kruse, Secretary

Subscribed and sworn to before me this 25th day of April, 1952.

William Wright
Notary Public

My Commission Expires: October 24, 1955.

PLUGGING
FILE SEC 1T-16R (8W)
BOOK PAGE 4-11-21