


15-16S-20630-0000

FORM CP-4

STATE OF KANSAS
STATE CORPORATION COMMISSION

WELL PLUGGING RECORD

Give All Information Completely
Make Required Affidavit
Mail or Deliver Report to
Conservation Division
State Corporation Comm.
245 North Water
Wichita, KS 67202

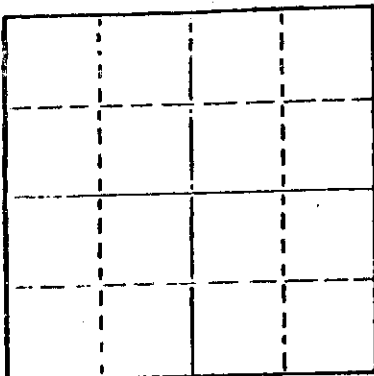

Locate well correctly on above
Section Plat

Rush County, Sec. 1 Twp. 16S Rge. 18W E/W
Location as "NE/CNW $\frac{1}{4}$ SW $\frac{1}{4}$ " or footage from lines
Ne SW SW
Lease Owner L. & L. Oil Operations
Lease Name Legleiter "A" Well No. 1
Office Address 1519 Haney, Hays, Kansas 67601
Character of Well (Completed as Oil, Gas or Dry Hole)
Dry Hole
Date Well completed 6-2-77 19
Application for plugging filed 6-2-77 19
Application for plugging approved 6-2-77 19
Plugging commenced 6:00 A.M. 6-2-77 19
Plugging completed 7:30 A.M. 6-2-77 19
Reason for abandonment of well or producing formation

D. & A.
If a producing well is abandoned, date of last production
None 19
Was permission obtained from the Conservation Division or
its agents before plugging was commenced? Yes

Name of Conservation Agent who supervised plugging of this well Leo Massey
Producing formation None Depth to top Bottom Total Depth of Well 3559'
Show depth and thickness of all water, oil and gas formations.

OIL, GAS OR WATER RECORDS 8 5/8 in 1148'

CASING RECORD

FORMATION	CONTENT	FROM	TO	SIZE	PUT IN	PULLED OUT
	None					

Describe in detail the manner in which the well was plugged, indicating where the mud fluid was placed and the method or methods used in introducing it into the hold. If cement or other plugs were used, state the character of same and depth placed, from feet to feet for each plug set.

Filled hole to 500' with heavy mud
Mixed 40 sacks 50-50 Poz. mix 2% gel and pumped thru drill pipe.
Filled hole to 40' pushed down plug and mixed 10 sacks of 50-50 Poz mix
2% gel and filled hole to bottom of cellar with cement.

JUN 03 1977

CONSERVATION DIVISION
STATE CORPORATION COMMISSION

(If additional description is necessary, use BACK of this sheet)

Name of Plugging Contractor Revlin Drlg., Inc.

STATE OF Kansas COUNTY OF Russell ss.

S. C. Lingreen

(employee of owner) or (owner or operator) of the above-described

well, being first duly sworn on oath, says: That I have knowledge of the facts, statements, and matters herein contained and the log of the above-described well as filed and that the same are true and correct. So help me God.

(Signature)

Box 88, Russell, Kansas 67665


(Address)

SUBSCRIBED AND SWORN TO before me this 2nd day of June, 1977

Lauraine Sullivan

Notary Public.

My commission expires January 29, 1981

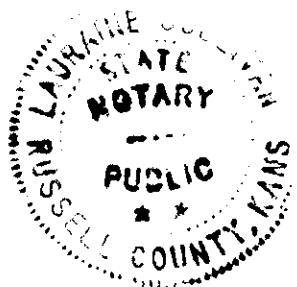



K-165-20638-0000

DON J. REVELL

913-483-4022

STANLEY C. LINGREEN

913-368-4516

OFFICE PHONE 913-483-5355

BOX 88

RUSSELL, KANSAS 67665

June 2, 1977

Well Log for the Legleiter #1 -A
Ne SW SW
Sec. 1, Twp. 16S, Rge. 18W
Rush County, Kansas

5-25-77 Daylight Tower
0' to 260' Top-soil, Post rock,
shale

Evening Tower
260' to 580' Shells & Shale
580' to 770' Dakota Sand
770' to 800' Redbed & Shale

5-26-77 Morning Tower
800' to 1128' Red Shale
1128' to 1122' Anhydrite

Daylight Tower
1122' to 1148' Anhydrite

Evening Tower
1148' W.O.C.

5-27-77 Morning Tower
1148' to 1166' Anhydrite
1166' to 1440' Shale

Daylight Tower
1440' to 1800' Shale & Shells
1800' to 1900' Lime With Shale

Evening Tower
1900' to 2105' Shale & Lime

5-28-77 Morning Tower
2105' to 2340' Ft. Riley

Daylight Tower
2340' to 2540' Lime with Shale

Evening Tower
2540' to 2775' Lime & Shale

5-29-77 Morning Tower
2775' to 2964' Shale & Lime

Daylight Tower
2964' to 3055' Lime

Evening Tower
3055' to 3203' Lime

5-30-77 Morning Tower
3203' to 3290' Lime

Daylight Tower
3290' Lime

Evening Tower
3290' to 3305' Lime

5-31-77 Morning Tower
3305' to 3372' Lime

Daylight Tower
3372' to 3460' Lime

Evening Tower
3460' to 3465' Lime

6-1-77 Morning Tower
3465' to 3534' Lime

Daylight Tower
3534' to 3557' Lime

Evening Tower
3557' to 3559' Lime

RECORDED
INDEXED
JUN 16 1977
RUSSELL, KANSAS