


WELL PLUGGING RECORD

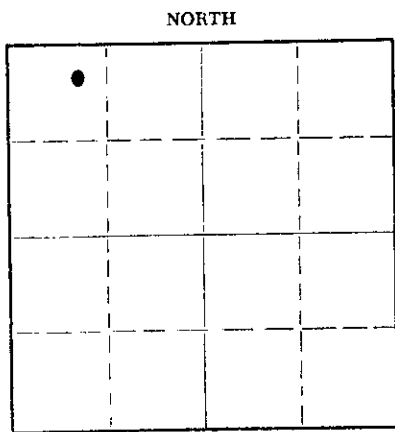

Locate well correctly on above
Section Plat

Rice County, Sec. 21 Twp. 21S Rge. 10 (E) 10 (W)
Location as "NE/CNW/SW" or footage from lines NE NW NW
Lease Owner Icer Addis
Lease Name Boy Well No. 1
Office Address P. O. Box 519, Great Bend, Kansas
Character of Well (completed as Oil, Gas or Dry Hole) Dry hole
Date well completed 9-1 19 62
Application for plugging filed 9-1 19 62
Application for plugging approved 9-1 19 62
Plugging commenced 9-1 19 62
Plugging completed 9-1 19 62
Reason for abandonment of well or producing formation dry hole

If a producing well is abandoned, date of last production 19
Was permission obtained from the Conservation Division or its agents before plugging was commenced? yes

Name of Conservation Agent who supervised plugging of this well Gilbert Toman
Producing formation dry hole Depth to top Bottom Total Depth of Well 3443 Feet
Show depth and thickness of all water, oil and gas formations.

OIL, GAS OR WATER RECORDS

CASING RECORD

FORMATION	CONTENT	FROM	TO	SIZE	PUT IN	PULLED OUT
Severy	gas	2544	2560	8-5/8"	204'	none
Lansing	dry	3041	3278			
Simpson	dry	3375	3432			
Arbuckle	water	3432	3443			

Describe in detail the manner in which the well was plugged, indicating where the mud fluid was placed and the method or methods used in introducing it into the hole. If cement or other plugs were used, state the character of same and depth placed, from feet to feet for each plug set.

Bottom plug @ 200' w/1/4 sk hulls & 20 cement thru drill pipe
Top plug @ 35' w/1/2 sk hulls & 10 cement

RECEIVED
STATE CORPORATION COMMISSION
SEP 11 1962
CONSERVATION DIVISION
Wichita, Kansas

(If additional description is necessary, use BACK of this sheet)
Name of Plugging Contractor Rotary well drilled - no pipe set.
Address

STATE OF OKLAHOMA, COUNTY OF TULSA, ss.
Joseph Teichman (employee of owner) or (owner or operator) of the above-described well, being first duly sworn on oath, says: That I have knowledge of the facts, statements, and matters herein contained and the log of the above-described well as filed and that the same are true and correct. So help me God.

(Signature)

P. O. Box 7027, Tulsa, Oklahoma
(Address)

SUBSCRIBED AND SWORN TO before me this 7th day of September, 19 62

My commission expires 3-17-64

Notary Public.

My commission expires: 3-17-64