


STATE OF KANSAS  
STATE CORPORATION COMMISSION

Give All Information Completely  
Make Required Affidavit  
Mail or Deliver Report to:  
Conservation Division  
State Corporation Commission  
211 No. Broadway  
Wichita, Kansas

WELL PLUGGING RECORD

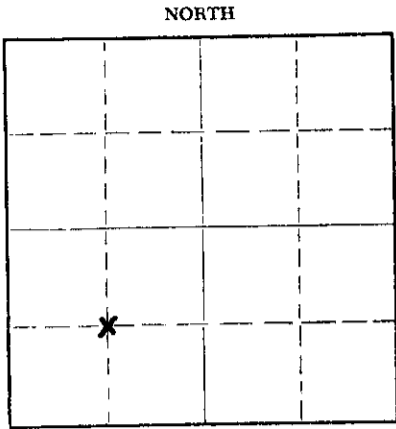

Locate well correctly on above  
Section Plat

Finney County. Sec. 8 Twp. 26 Rge. 31 (W)  
Location as "NE/CNW/SW" or footage from lines C SW  
Lease Owner Kansas-Nebraska Natural Gas Company, Inc.  
Lease Name Brensing Well No. 1  
Office Address Hastings, Nebraska  
Character of Well (completed as Oil, Gas or Dry Hole) Dry Hole  
Date well completed July 21 19 56  
Application for plugging filed November 20 19 56  
Application for plugging approved November 21 19 56  
Plugging commenced December 1 19 56  
Plugging completed December 2 19 56  
Reason for abandonment of well or producing formation  
Dry Hole

If a producing well is abandoned, date of last production None 19  
Was permission obtained from the Conservation Division or its agents before plugging was commenced? Yes

Name of Conservation Agent who supervised plugging of this well Mr. Merle Rives  
Producing formation \_\_\_\_\_ Depth to top \_\_\_\_\_ Bottom \_\_\_\_\_ Total Depth of Well 2720 Feet  
Show depth and thickness of all water, oil and gas formations.

OIL, GAS OR WATER RECORDS

CASING RECORD

FORMATION	CONTENT	FROM	TO	SIZE	PUT IN	PULLED OUT
Herrington	Water	2640	2656	8 5/8	553'	0
Krider	Water	2675	2706	5 1/2	2719'	1795'

Describe in detail the manner in which the well was plugged, indicating where the mud fluid was placed and the method or methods used in introducing it into the hole. If cement or other plugs were used, state the character of same and depth placed, from \_\_\_\_\_ feet to \_\_\_\_\_ feet for each plug set.

Plugged back with crushed rock to 2645', dumped 5 sax cement @ 2645' with dump bailer. Top of cement 2610'. Pumped in 15 sax gel mud @ 1300' by Halliburton. Filled hole with mud to 325', set rock bridge, dumped 20 sax cement. Top cement 260'. Filled hole with mud to 35', set rock bridge, dumped 10 sax cement for cap.

(If additional description is necessary, use BACK of this sheet)

Name of Plugging Contractor Miller Casing Pulling Company  
Address Great Bend, Kansas

STATE OF Nebraska, COUNTY OF Adams, ss.  
Mr. S. D. Ford, Jr. (employee of owner) or (owner) of the above-described well, being first duly sworn on oath, says: That I have knowledge of the facts, statements, and matters herein contained and the log of the above-described well as filed and that the same are true and correct. So help me God.

(Signature) *S. D. Ford, Jr.* S. D. FORD, JR.  
Hastings, Nebraska (Address)

SUBSCRIBED AND SWORN TO before me this 12<sup>th</sup> day of December, 1956

My commission expires October 23, 1959 J. ROLAND MILLER Notary Public.

PLUGGING  
FILE SEC 8 T. 26 R. 31W  
BOOK PAGE 118 LINE 34

CONSERVATION DIVISION  
Wichita, Kansas  
12-13-56


WELL LOG BUREAU—KANSAS GEOLOGICAL SOCIETY  
508 East Murdock, Wichita, Kansas

Company- KANSAS-NEBRASKA NATURAL GAS CO., INC.  
Farm- Brensing No. 1

SEC. 8 T. 26 R. 31W  
C SW

Total Depth. 2720'  
Comm. 7-17-56 Comp. 7-21-56  
Shot or Treated.  
Contractor. Bennett & Roberts Drlg.  
Issued. 9-29-56

County Finney  
KANSAS

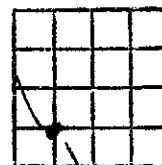

Elevation. 2827' RB

Production. Dry

CASING:

8 5/8" 553' w/375 sx cem.  
5 1/2" 2719' w/200 sx cem.

Figures indicate Bottom of Formations.

clay	35
sand	45
shale	70
sand-wtr-gravel	210
sand-shale	340
sdv shale	500
shale	575
red bed-shale	1205
shale-lime-red bed	1320
Anhydrite	1360
red bed-shale	1765
shale-lime strks	2045
lime-shale	2720
Total Depth	

TOPS: Scout	
Herrington	2640
Krider	2675