

STATE OF KANSAS
STATE CORPORATION COMMISSION

WELL PLUGGING RECORD

Give All Information Completely
Make Required Affidavit
Mail or Deliver Report to
Conservation Division
State Corporation Comm.
245 North Water
Wichita, KS 67202

Greeley County, Sec. 8 Twp. 20S Rge. 40 ~~XX~~/W
Location as "NE/CNW $\frac{1}{4}$ SW $\frac{1}{4}$ " or footage from lines _____

C/NW/NE
Lease Owner Bartling Oil Company
Lease Name Peter Well No. 2

Office Address 8550 Katy Freeway, Ste. 128, Houston, TX 77024

Character of Well (Completed as Oil, Gas or Dry Hole) _____

Gas

Date Well completed Oct. 31 1981

Application for plugging filed March 22 1982

Application for plugging approved April 5 1982

Plugging commenced May 28 1982

Plugging completed May 28 1982


Reason for abandonment of well or producing formation _____

Dry Hole

If a producing well is abandoned, date of last production _____

None 19____

Was permission obtained from the Conservation Division or its agents before plugging was commenced? Yes

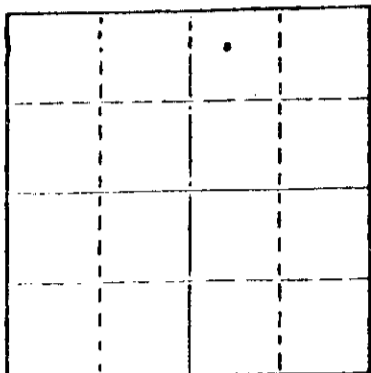

Locate well correctly on above Section Plat

Name of Conservation Agent who supervised plugging of this well Clarence Thomas

Producing formation L. Winfield Depth to top 2897 Bottom 2917 Total Depth of Well 2935

Show depth and thickness of all water, oil and gas formations.

OIL, GAS OR WATER RECORDS

CASING RECORD

FORMATION	CONTENT	FROM	TO	SIZE	PUT IN	PULLED OUT
Blue Shale	Shale	Gr	288	8-5/8"	288'	--
				4-1/2"	2942'	--

Describe in detail the manner in which the well was plugged, indicating where the mud fluid was placed and the method or methods used in introducing it into the hold. If cement or other plugs were used, state the character of same and depth placed, from _____ feet to _____ feet for each plug set.

RU Dowell cementer - pump 150 sx 50/50 Pozmix down 4 1/2" casing - disp. w/ 2 bbls. fresh water. Complete 10:26 a.m., 5/28/82.

(If additional description is necessary, use BACK of this sheet)

Name of Plugging Contractor Dowell


STATE OF Kansas COUNTY OF Seward, ss.
Reed Wacker (employee of owner) or (owner or operator)
of the above-described well, being first duly sworn on oath, says: That I have knowledge of the facts, statements, and matters herein contained and the log of the above-described well as filed and that the same are true and correct. So help me God.

(Signature) Reed Wacker
P.O. Box 6; Liberal, KS 67901
(Address)

SUBSCRIBED AND SWORN TO before me this 8th day of June, 19 82

A. J. Parnell
Notary Public.

My commission expires

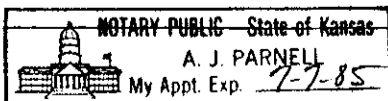

RECEIVED
STATE CORPORATION COMMISSION

6-9-82
CONSERVATION DIVISION
Wichita, Kansas