

STATE OF KANSAS
STATE CORPORATION COMMISSION


Give All Information Completely
Make Required Affidavit
Mail or Deliver Report to:
Conservation Division
State Corporation Commission
800 Bitting Building
Wichita, Kansas

15101-00031-0000
WELL PLUGGING RECORD

OR
FORMATION PLUGGING RECORD

Strike out upper line
when reporting plug-
ging of formations.

NORTH

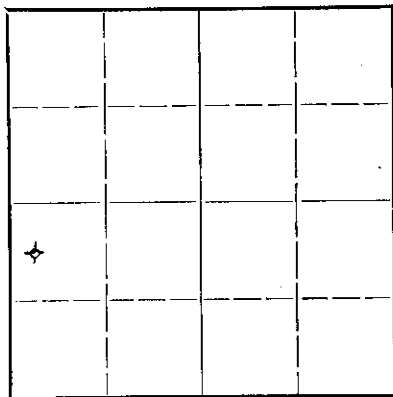

Locate well correctly on above
Section Plat

Lane _____ County Sec. 8 Twp 16S Rge. 30 ~~XXX~~ (W)
Location as "NE $\frac{1}{4}$ NW $\frac{1}{4}$ SW $\frac{1}{4}$ " or footage from lines CWL NW/4 SW/4
Lease Owner W. H. Black et al
Lease Name Cooley Well No. 1
Office Address 1314 Union National Bank Bldg., Wichita 2, Kansas
Character of Well (completed as Oil, Gas or Dry Hole) Dry Hole
Date well completed January 10 19 48
Application for plugging filed January 10, 19 48
Application for plugging approved January 16, 19 48
Plugging commenced January 10 19 48
Plugging completed January 10 19 48
Reason for abandonment of well or producing formation Dry
If a producing well is abandoned, date of last production _____ 19 _____
Was permission obtained from the Conservation Division or its agents before plugging was com-
menced? Yes

Name of Conservation Agent who supervised plugging of this well H. W. Kerr
Producing formation _____ Depth to top _____ Bottom _____ Total Depth of Well 4446 Feet
Show depth and thickness of all water, oil and gas formations.

OIL, GAS OR WATER RECORDS

CASING RECORD

Formation	Content	From	To	Size	Put In	Pulled Out
		0	447	10 3/4"	X 465'	

Describe in detail the manner in which the well was plugged, indicating where the mud fluid was placed and the method or methods used in introducing it into the hold. If cement or other plugs were used, state the character of same and depth placed, from _____ 0 _____ feet to 4446 feet for each plug set.

Filled hole with heavy mud. Spotted plug @ 447' and cemented with 15 sacks cement. Spotted plug in top of surface pipe and cemented with 10 sacks of cement, then cut pipe off below plow depth.

(If additional description is necessary, use BACK of this sheet)


Correspondence regarding this well should be addressed to W. H. Black
Address 1314 Union National Bank Building, Wichita 2, Kansas

STATE OF Kansas, COUNTY OF Sedgwick, SS.
Leon F. Huff, Attorney-in-Fact for W. H. Black, one of the owners of the above-described well,
being first duly sworn on oath, says: That I have knowledge of the facts, statements, and matters herein contained and the log of the above-described well as filed and that the same are true and correct. So help me God.

(Signature) Leon F. Huff
1314 Union National Bank Bldg., Wichita 2, Kansas
(Address)

SUBSCRIBED AND SWORN to before me this 14th day of January, 19 48
Mildred Stofkie
Notary Public.

My commission expires November 5, 1951.

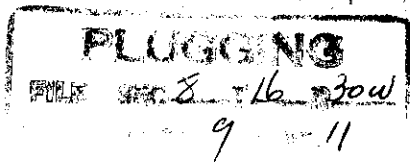

DRILLING LOG

OPERATOR: W. H. Black et al LOCATION: CWL NW SW
 FARM NAME: Cooley Sec. 8-16S-30W
 WELL NUMBER: 1 Lane County, Kansas

ROTARY COMMENCED: December 19, 1947 CASING RECORD:
 ROTARY COMPLETED: January 10, 1948 10 3/4" @ 447'
 Cera. 200 sacks

ELEVATION: 2692' DF PRODUCTION: Dry

Figures denote bottom of formations

<u>Formation</u>	<u>Depth</u>	<u>Formation</u>	<u>Depth</u>
Sand	15	Shale and Lime	3425
Shale	205	Bro. Lime	3495
Sand and Shale	290	Lime and Shale	3615
Shale and Shells	443	Shale and Lime	3695
Hard Rock	447	Lime and Shale	3765
Shale	675	Lime	3815
Sand and Shells	820	Lime, Bro.	3860
Shale and Shells	1320	Lime	3887
Sand	1375	Shale and Lime	3950
Shale and Shells	1630	Lime and Shale	4094
Lime	1635	Lime	4158
Lime and Shale	1750	Lime and Shale	4177
Sand and Shale	1910	Sandy Lime and Shale	4235
Red Bed and Shale	2115	Lime	4278
Anhydrite	2140	Sandy Lime and Shale	4347
Shale	2145	Lime and Shale	4406
Lime and Shale	2265	Lime	4446
Red Bed, Shale and Shells	2325	Total Depth	
Shale and Lime	2370		
Lime and Shale	2450		
Sandy Shale and Shells	2530	<u>TOPS</u>	
Lime and Shale	2550	Anhydrite	2115
Shale, Lime and Shells	2645		
Shale and Lime	2680		
Lime	2700	Mississippi	4354
Shale	2720	Slight show dead oil	4354-63
Lime and Shale	3240		

STATE OF KANSAS)
 SEDGWICK COUNTY) SS

I, Leon F. Huff, as attorney-in-fact for W. H. Black, do hereby certify that the foregoing, to the best of my knowledge and belief, is a full, true and correct drilling log as shown by the daily drilling reports in connection with the aforesaid well.

Leon F. Huff
 Attorney-in-Fact for W. H. Black

Subscribed and sworn to before me, the undersigned, a Notary Public, this 13th day of January, 1948.

Mildred Hobbs
 Notary Public

My commission expires
 November 5, 1951.

PLUGGING
 SEC 8 T 16 S 30W
 PAGE 9 OF 11