


STATE OF KANSAS
STATE CORPORATION COMMISSION

WELL PLUGGING RECORD

Give All Information Completely
Make Required Affidavit
Mail or Deliver Report to
Conservation Division
State Corporation Comm.
245 North Water
Wichita, KS 67202

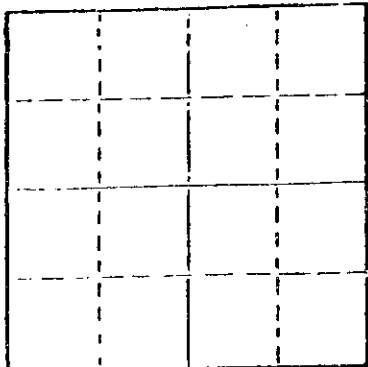

Locate well correctly on above
Section Plot

AMB
PLC
Location Wilson County, Sec. 12 Twp. 28 Rge. 16 E/W
Location "NE/CNW $\frac{1}{2}$ SW $\frac{1}{2}$ " or footage from lines _____
SE NW SW 1155' FSL, 1155' FWL
Lease Owner Markan Oil, Inc.
Lease Name Gilchrist Well No. 1
Office Address P.O. Box 537, Chanute, KS 66720
Character of Well (Completed as Oil, Gas or Dry Hole) _____
Dry hole
Date Well completed 8-19 1983
Application for plugging filed 8-22 1983
Application for plugging approved 8-22 1983
Plugging commenced 8-23 1983
Plugging completed 8-23 1983
Reason for abandonment of well or producing formation _____
Dry hole

If a producing well is abandoned, date of last production _____
19____

Was permission obtained from the Conservation Division or
its agents before plugging was commenced? Yes

Name of Conservation Agent who supervised plugging of this well Tom Bilyeu
Producing formation _____ Depth to top _____ Bottom _____ Total Depth of Well 1216
Show depth and thickness of all water, oil and gas formations.

OIL, GAS OR WATER RECORDS

CASING RECORD

FORMATION	CONTENT	FROM	TO	SIZE	PUT IN	PULLED OUT
See attached log						

Describe in detail the manner in which the well was plugged, indicating where the mud fluid
was placed and the method or methods used in introducing it into the hold. If cement or other
plugs were used, state the character of same and depth placed, from _____ feet to
_____ feet for each plug set.

15 sks @ T.D.
15 sks @ 600'
Fill w/57 sks from 350' to surface

(If additional description is necessary, use BACK of this sheet)

Name of Plugging Contractor Osage Drilling, Inc.

STATE OF Kansas COUNTY OF Neosho, ss.
(employee of owner) or (owner or operator)

of the above-described well, being first duly sworn on oath, says: That I have knowledge of
the facts, statements, and matters herein contained and the log of the above-described well
as filed and that the same are true and correct. So help me God.

(Signature) J. Ballard
P.O. Box 537, Chanute, KS 66720
(Address)

SUBSCRIBED AND SWORN TO before me this 24th day of August, 19 83

Erma P. Willis
Notary Public.

My commission expires December 11, 1985

AUG 26 1983
Wichita, Kansas

